


2 NORTH / SOUTH SECTION BETWEEN GRIDS 11 + 12

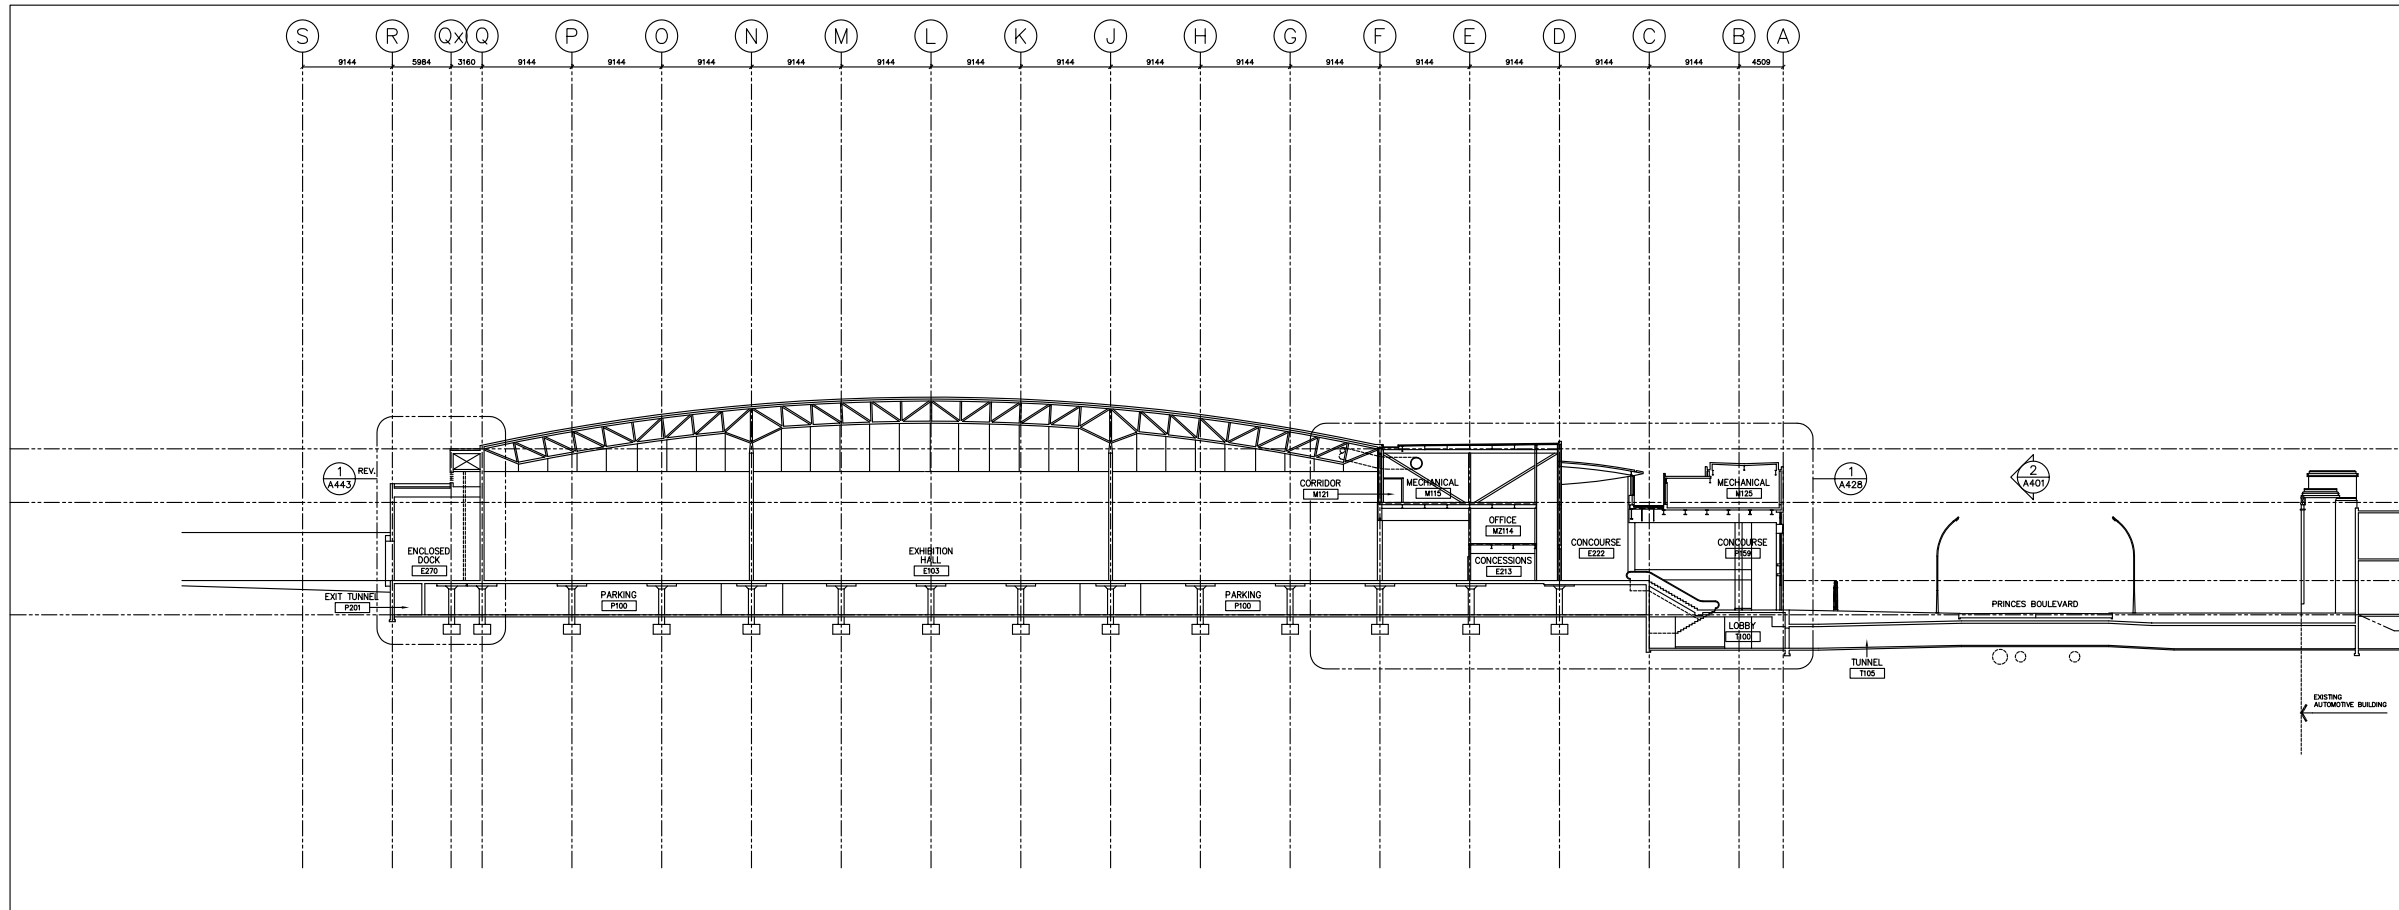

1 NORTH / SOUTH SECTION BETWEEN GRIDS 40 + 41

REVISED TO INCORPORATE FIELD INSTRUCTIONS, CHANGE ORDERS AND AS-BUILT INFORMATION SUPPLIED BY THE CONTRACTOR

CERTIFIED AS BUILT
PCL DESIGN CONSTRUCTORS INC.
February 28, 1997

No.	Revisions	Date
8	RECORD DRAWING	28 FEB 97
7	REVISED TO INCORPORATE UP TO FIA 320	10 JAN 97
6	REVISED TO INCORPORATE UP TO FIA 299	10 DEC 96
5	REVISED TO INCORPORATE FIA 01 TO 161 & CRX 01 TO 135	12 JULY 96
4	FIA 089	22 MAR 96
3	ISSUED FOR CONSTRUCTION	4 APRIL 96
2	ISSUED FOR CONSTRUCTION	29 MAR 96
1	ISSUED FOR BUILDING PERMIT	23 FEB 96

BOARD OF GOVERNORS OF EXHIBITION PLACE
EXHIBITION PLACE TORONTO
M&P

Zeidler Roberts Partnership
DUNLOP FARROW
ARCHITECTS IN JOINT VENTURE

NATIONAL TRADE CENTRE AT EXHIBITION PLACE

Drawn	LOH/ACAD	Scale	1:250
Checked	-	Date	05 JULY 1995
Title			
NORTH / SOUTH BUILDING SECTIONS			
Project No.	NTC-C-201	Drawing No.	A420

EXHIBITION PLACE