

NOTES:
 REFER TO INCORPORATE FIELD INSTRUCTIONS, CHANGE THE CONTRACTOR.
 THE CONTRACTOR.

CERTIFIED AS BUILT
 Univex (Ontario) Limited
[Signature]
 February 28, 1997

No.	Description	Date	By
17	ADDITIONAL CONTRACTOR'S COMMENTS	MAY 13/97 C.V.B.	
16	ISSUED FOR PROGRESS REVIEW	FEB 26/97 C.V.B.	
15	ISSUED FOR PROGRESS REVIEW	JAN 15/97 C.V.B.	
14	ISSUED FOR PROGRESS REVIEW	NOV 17/96 C.V.B.	
13	FIELD INSTRUCTION # E-10 & E-11	NOV 17/96 C.V.B.	
12	FIELD INSTRUCTION # E-10	OCT 27/96 C.V.B.	
11	FIELD INSTRUCTION # E-10	OCT 27/96 C.V.B.	
10	FIELD INSTRUCTION # E-10	OCT 27/96 C.V.B.	
9	FIELD INSTRUCTION # E-10 & E-11	APR 22/96 C.V.B.	
8	ISSUED FOR PROGRESS REVIEW	DEC 27/95 C.V.B.	
7	ISSUED FOR PROGRESS REVIEW	DEC 27/95 C.V.B.	
6	ISSUED FOR PROGRESS REVIEW	DEC 27/95 C.V.B.	
5	ISSUED FOR PROGRESS REVIEW	DEC 27/95 C.V.B.	
4	ISSUED FOR PROGRESS REVIEW	DEC 27/95 C.V.B.	
3	ISSUED FOR PROGRESS REVIEW	DEC 27/95 C.V.B.	
2	ISSUED FOR PROGRESS REVIEW	DEC 27/95 C.V.B.	
1	ISSUED FOR PROGRESS REVIEW	DEC 27/95 C.V.B.	

CONTRACTOR SHALL VERIFY ALL DIMENSIONS ON THE JOB.
 THE CONTRACTOR SHALL BE RESPONSIBLE FOR OBTAINING ALL NECESSARY PERMITS.
 THESE DIMENSIONS ARE FOR INFORMATION ONLY.


Central Park Engineering Inc.
 Consulting Engineers
 1000 SHEPPARD AVENUE EAST, SUITE 100
 SCARBOROUGH, ONTARIO M1S 1T2
 TEL: (416) 291-1111
 FAX: (416) 291-1112

THE BOARD OF GOVERNORS OF EXHIBITION PLACE
 NATIONAL TRADE CENTRE
 AT
 EXHIBITION PLACE

Project No. NTC-C-201
 Drawing No. E-215

Scale: 1:125
 Date: APRIL 95

Checked: D.T./S.B./G
 C.V.B.

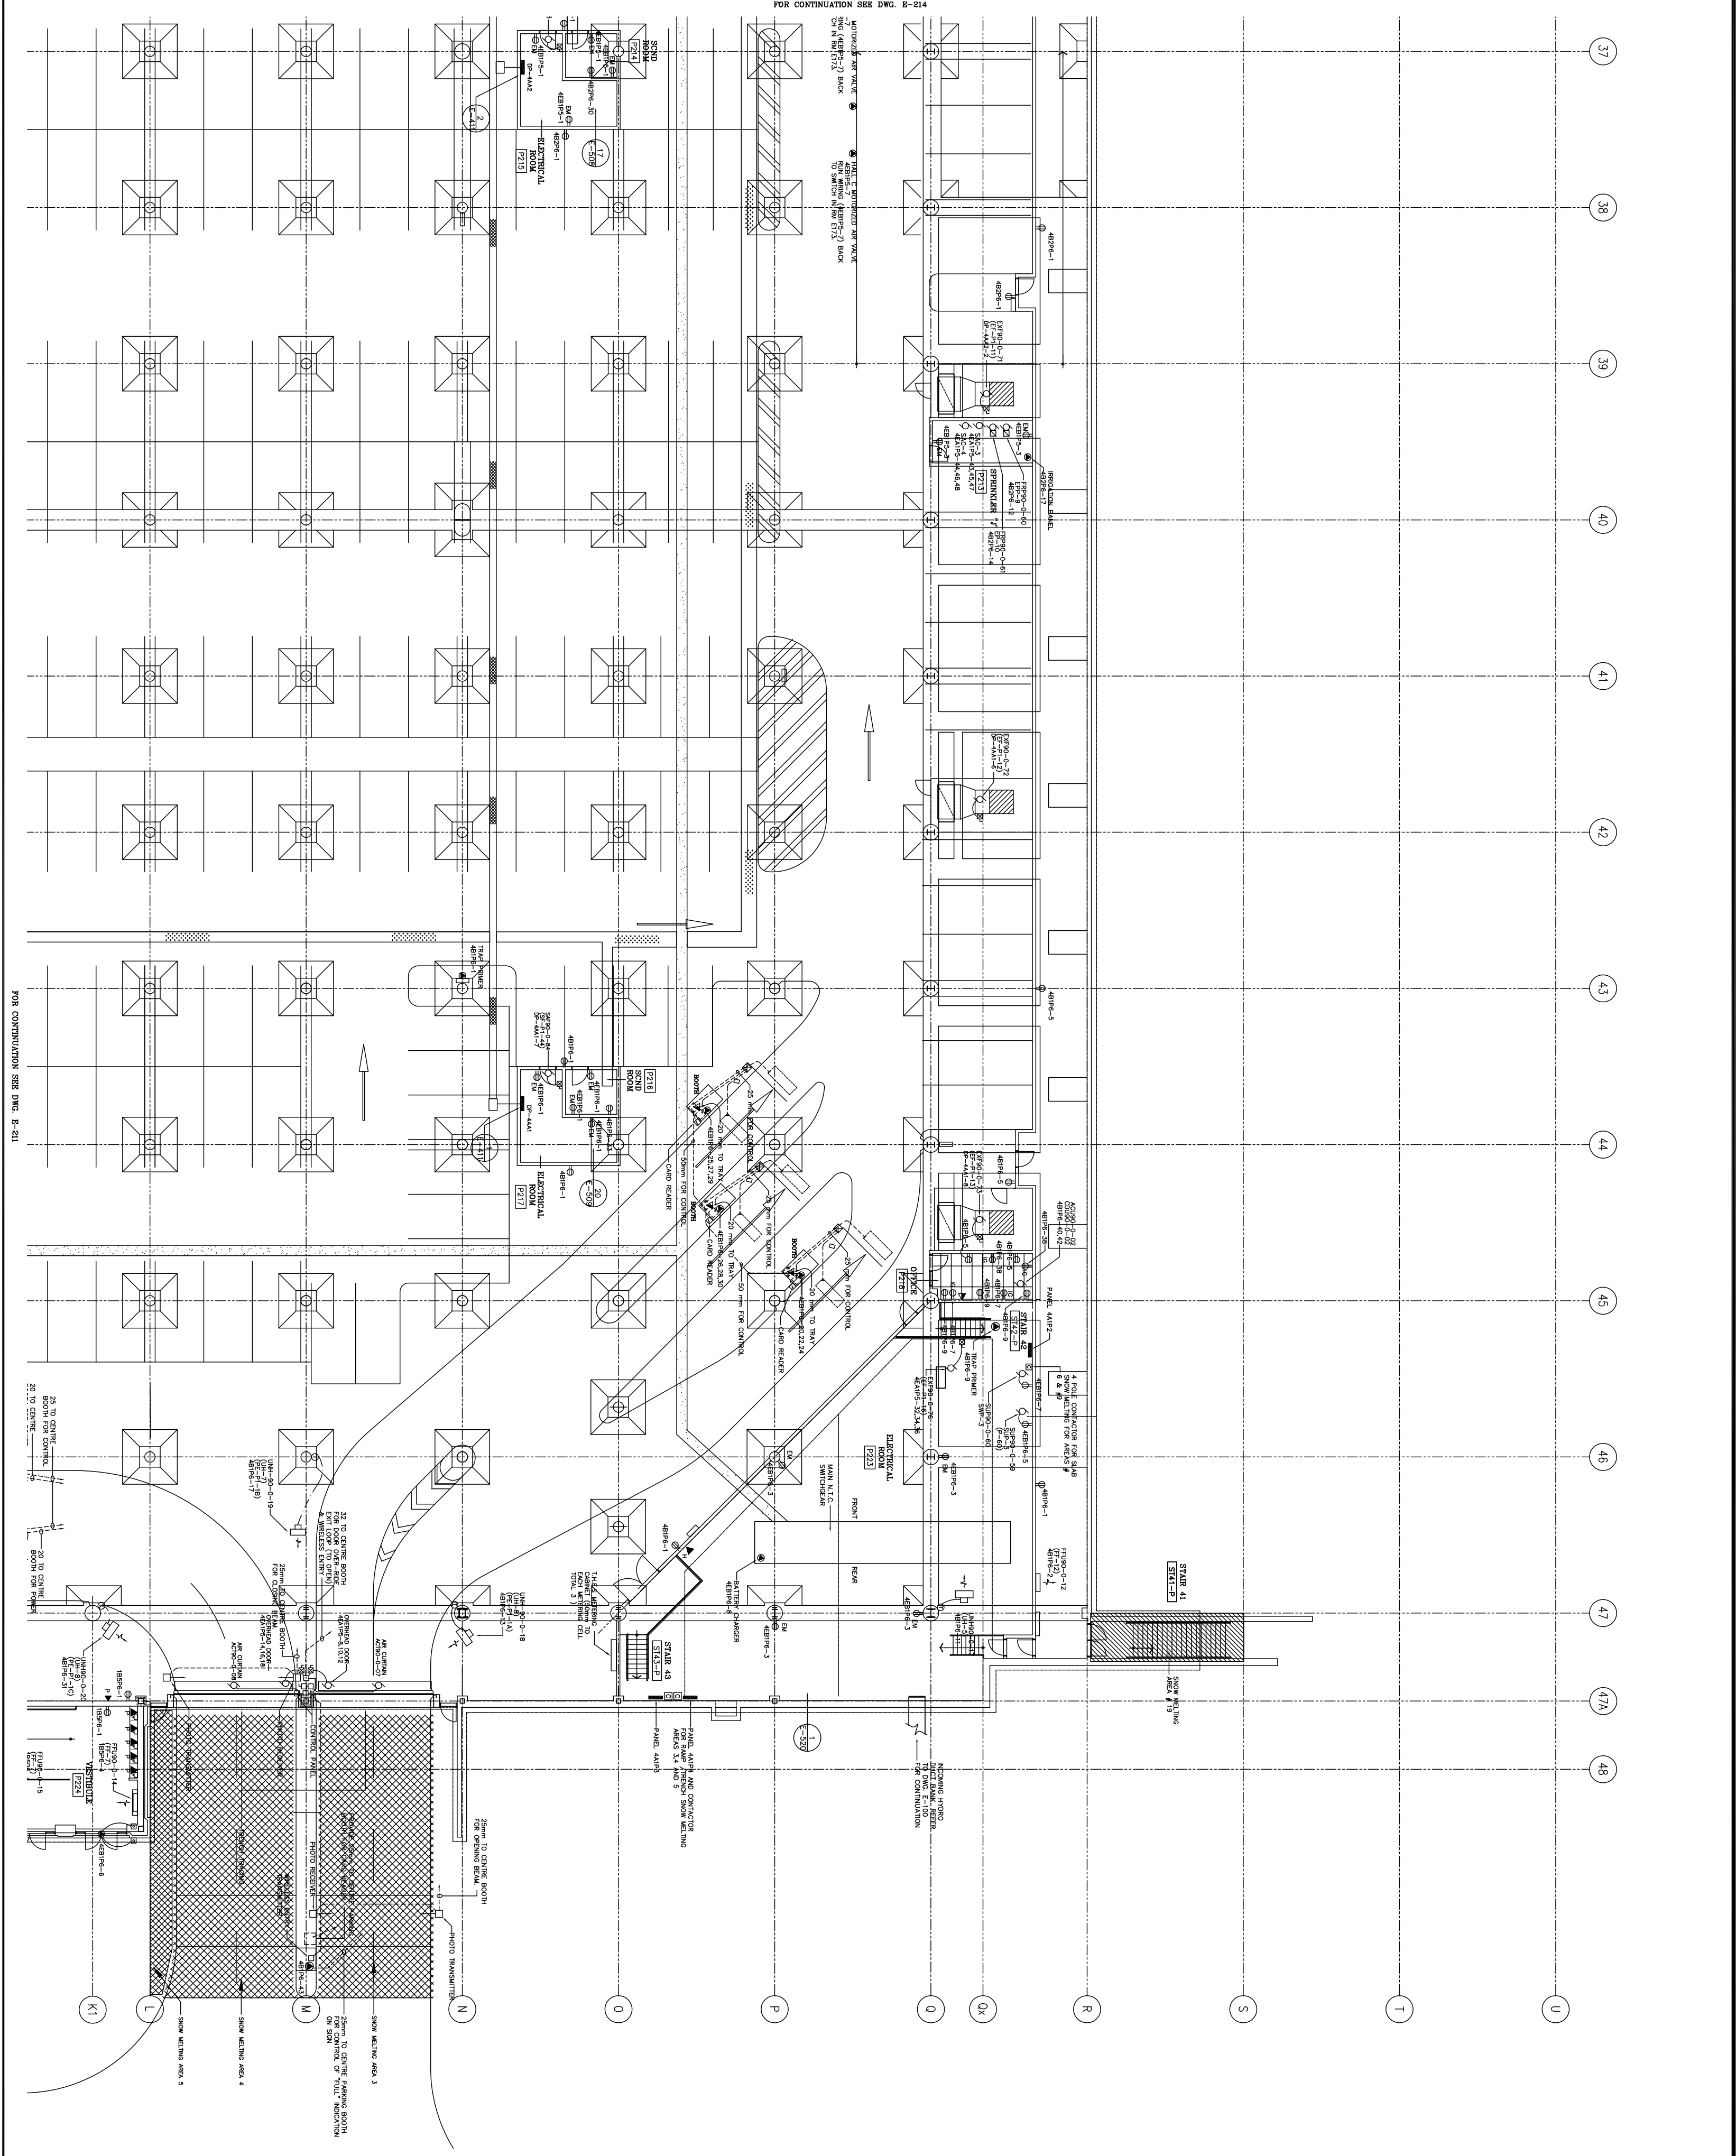

FOR CONTINUATION SEE DWG. E-214

FOR CONTINUATION SEE DWG. E-211