


APPENDIX C

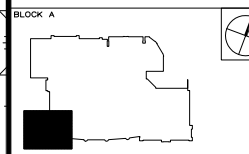

NOTES

REVISED TO INCORPORATE
FIELD INSTRUCTIONS, CHANGE
ORDERS AND AS-BUILT
INFORMATION SUPPLIED BY
THE CONTRACTOR

CERTIFIED AS BUILT

PCL DESIGN CONSTRUCTORS INC.

February 28, 1997

13	RECORD DRAWING	97-2-28
12	REVISED TO INCORPORATE UP TO FIA 330	97-1-10
11	REVISED TO INCORPORATE UP TO FIA 298	96-12-10
10	REVISED TO INCORPORATE FIA Q1 TO 161 & Q2K OF TO 135	96-7-12
9	ISSUED FOR CONSTRUCTION	96-4-4
8	ISSUED FOR BUILDING PERMIT	96-2-28
7	ISSUED FOR PROGRESS REVIEW	96-1-1
6	ISSUED FOR PROGRESS REVIEW	95-12-1
5	ISSUED FOR PROGRESS REVIEW	95-11-1
4	ISSUED FOR PROGRESS REVIEW	95-10-1
3	ISSUED FOR REVIEW BY PCL	95-10-27
2	ISSUED FOR PROGRESS REVIEW	95-9-01
1	ISSUED FOR PROGRESS REVIEW	95-9-01
No.	Revisions	Date By

CONTRACTOR MUST CHECK AND VERIFY ALL DIMENSIONS ON THE JOB.
DRAWING MUST NOT BE REUSED.



Zeidler Roberts Partnership

DUNLOP FARROW

ARCHITECTS IN JOINT VENTURE

NATIONAL TRADE CENTRE
AT
EXHIBITION PLACE

Drawn
Checked
Title
Scale
Date
1:125
96-2-26


P1 LEVEL PLAN
BLOCK A



Project No.
NTC-C-201

Drawing No.
A-220

DFA PROJECT NO. 95045

EXHIBITION PLACE

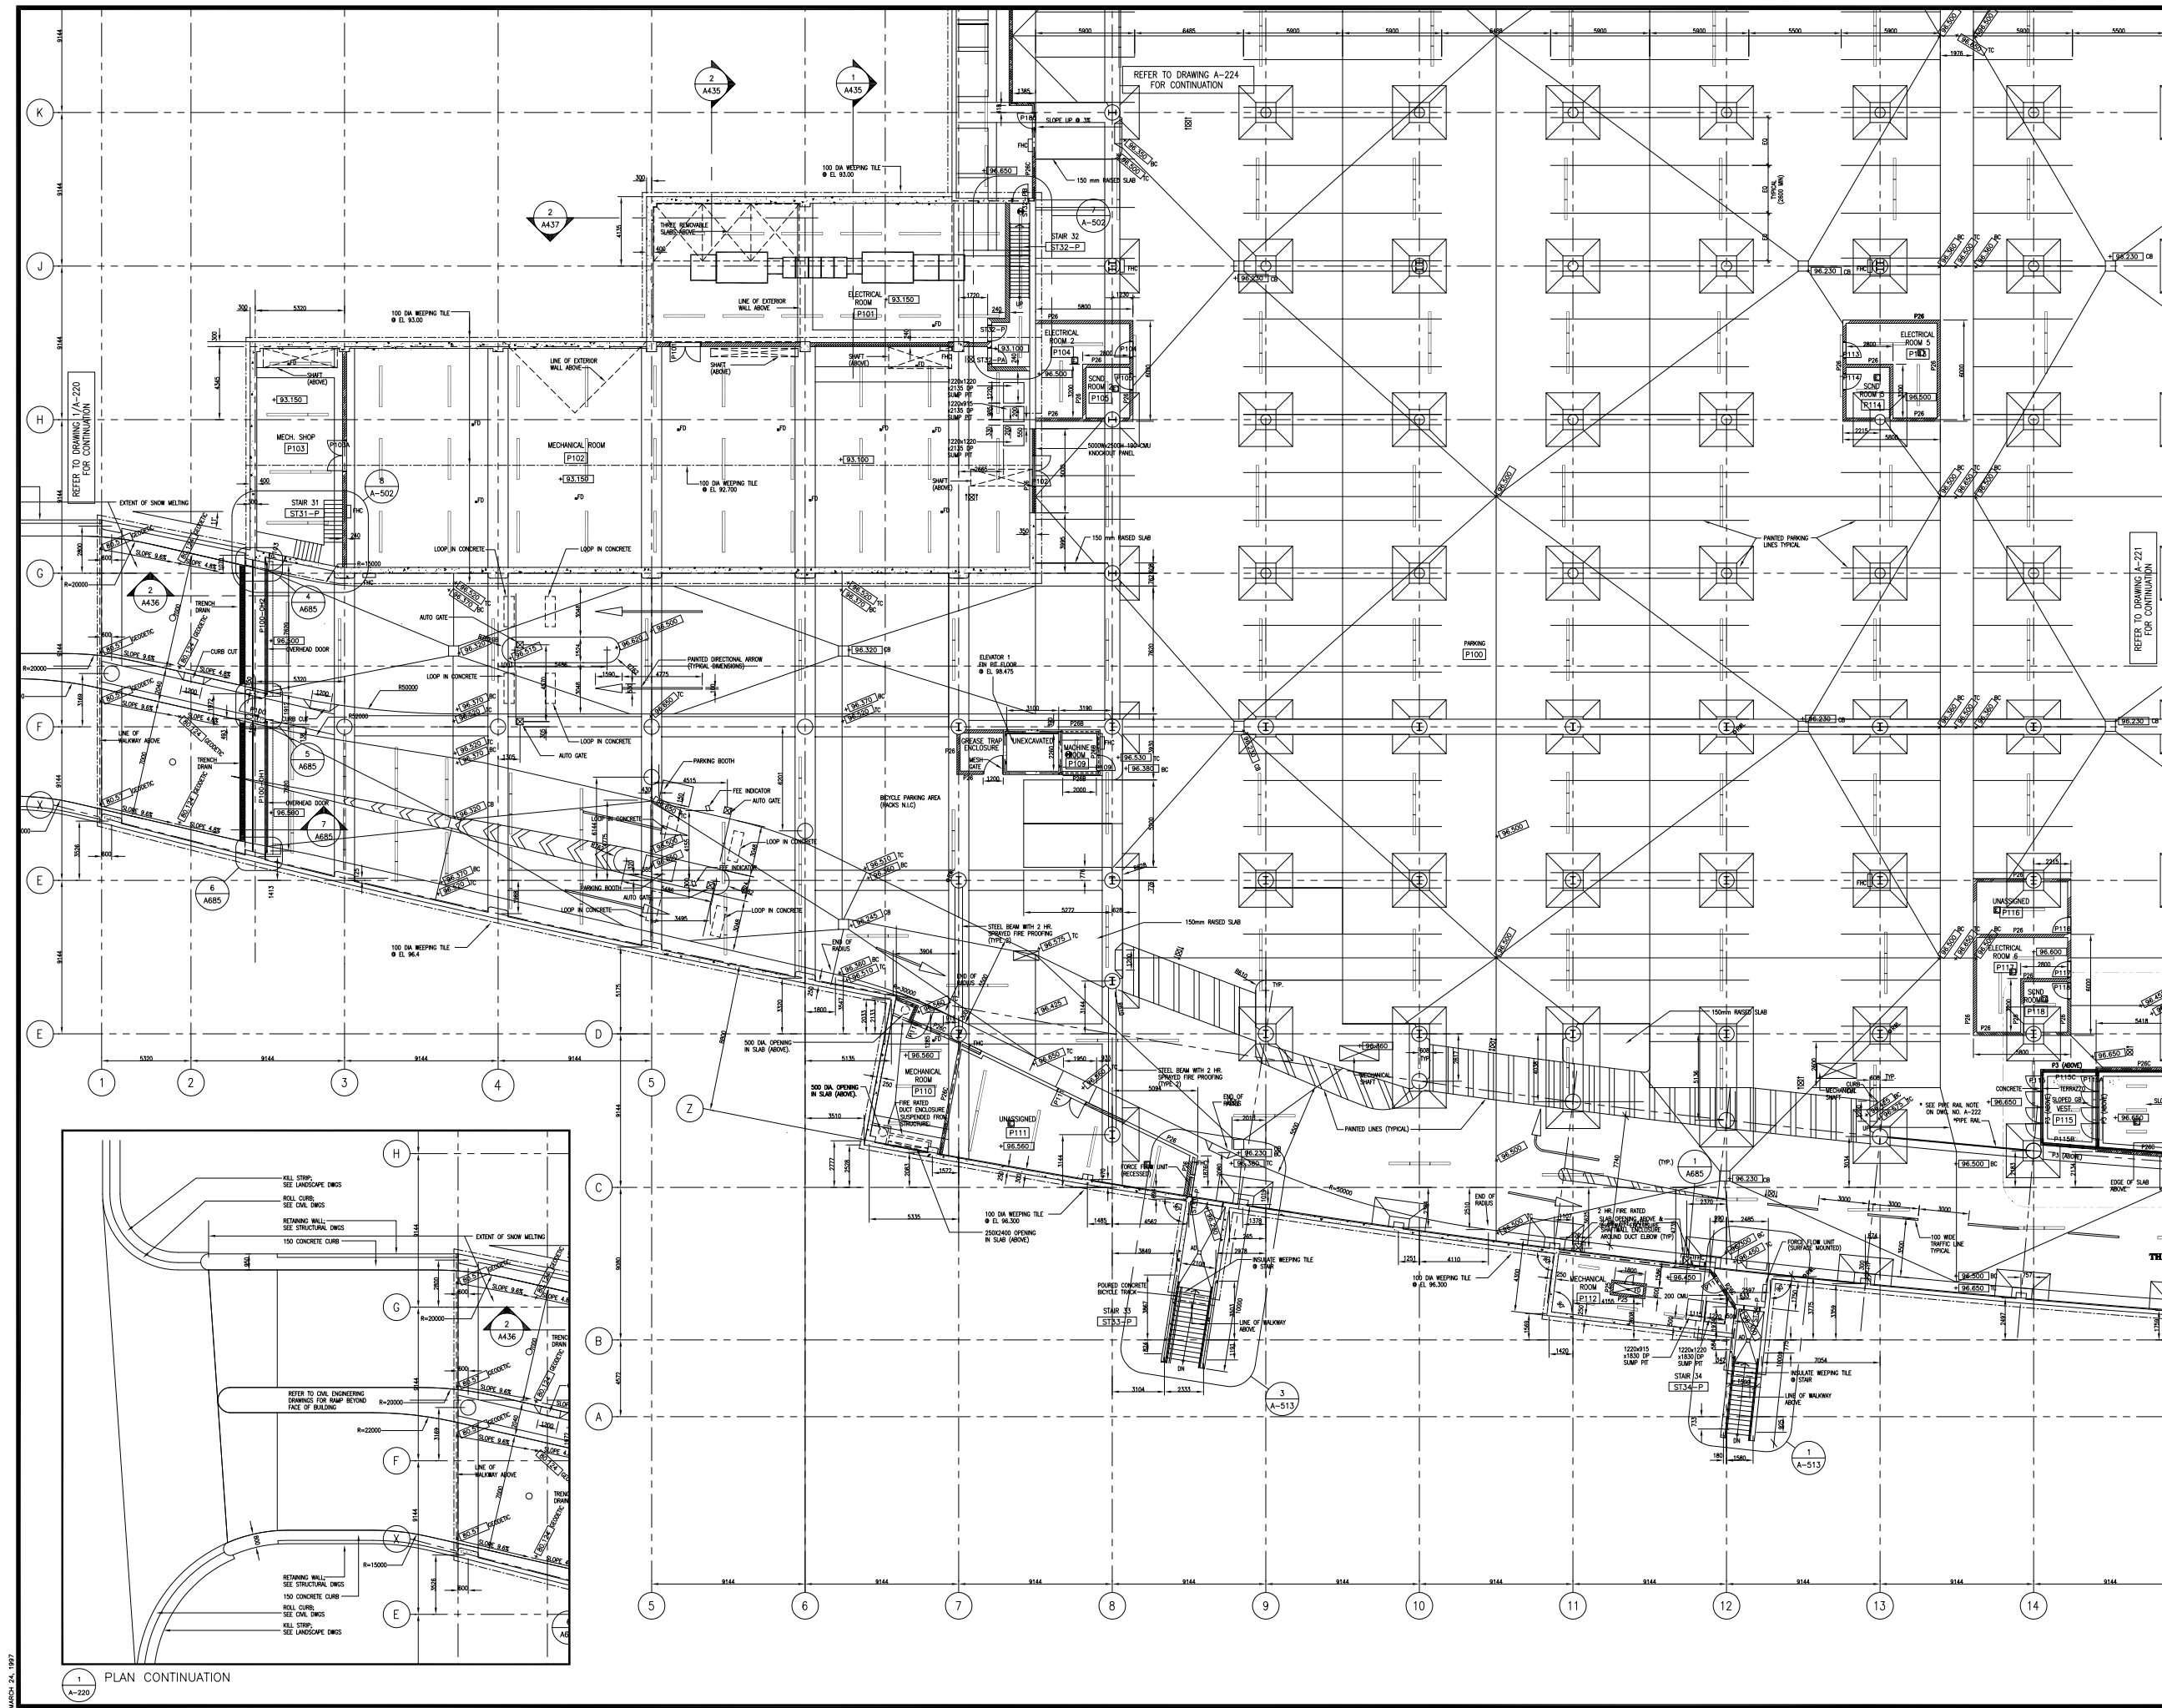

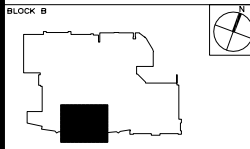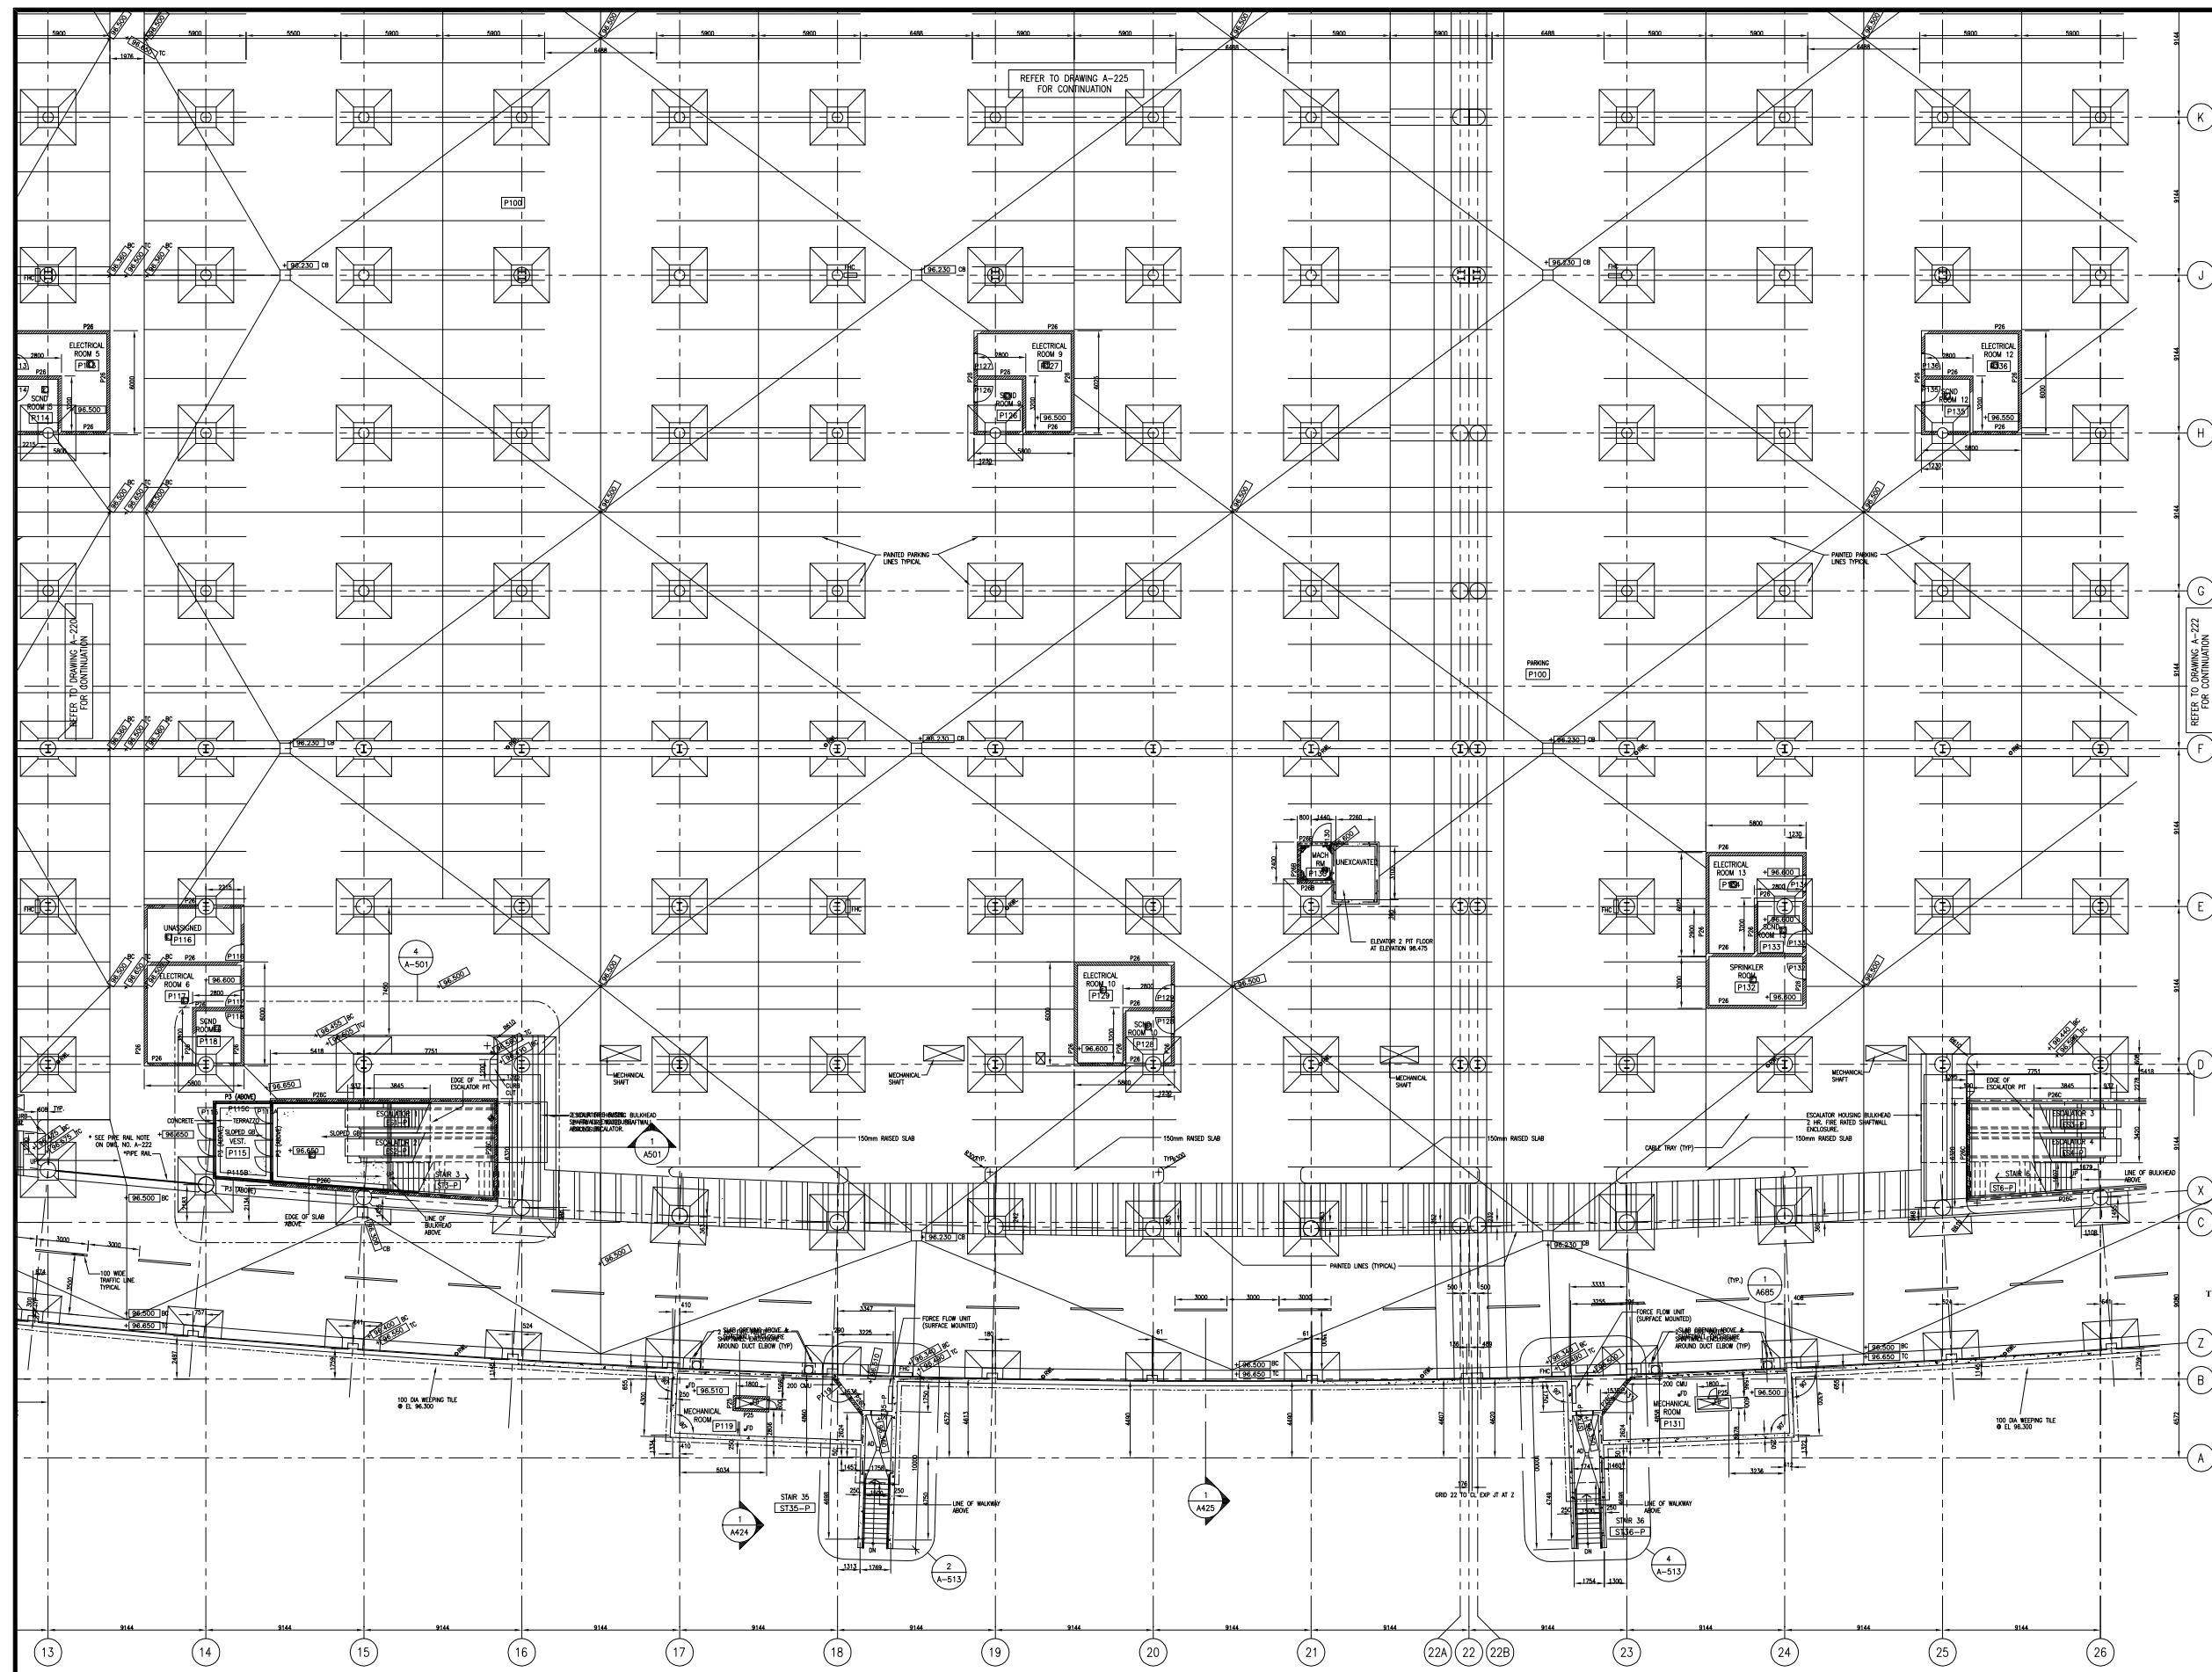

NOTES

REVISED TO INCORPORATE FIELD INSTRUCTIONS, CHANGE ORDERS AND AS-BUILT INFORMATION SUPPLIED BY THE CONTRACTOR

CERTIFIED AS BUILT
PCL DESIGN CONSTRUCTORS INC.
Richard Green
February 28, 1997

13	RECORD DRAWING	97-2-28
12	REVISED TO INCORPORATE UP TO FIA 320	97-1-10
11	REVISED TO INCORPORATE UP TO FIA 298	96-12-10
10	REVISED TO INCORPORATE FIA 01 TO 161 & 02X 01 TO 135	96-7-12
9	ISSUED FOR CONSTRUCTION	96-4-4
8	ISSUED FOR BUILDING PERMIT	96-2-26
7	ISSUED FOR PROGRESS REVIEW	96-1-10
6	ISSUED FOR PROGRESS REVIEW	95-12-10
5	ISSUED FOR PROGRESS REVIEW	95-11-10
4	ISSUED FOR PROGRESS REVIEW	95-10-27
3	ISSUED FOR REVIEW BY PCL	95-10-27
2	ISSUED FOR PROGRESS REVIEW	95-9-01
1	ISSUED FOR PROGRESS REVIEW	95-9-01
No.	Revisions	Date By

CONTRACTOR MUST VERIFY ALL DIMENSIONS ON THE JOB. DRAWING MUST NOT BE SCALE.




Zeider Roberts Partnership
BUNLOP FARROW
ARCHITECTS IN JOINT VENTURE

NATIONAL TRADE CENTRE
AT
EXHIBITION PLACE

Drawn: — Scale: 1:125
Checked: — Date: 96-2-26

Title: P1 LEVEL PLAN BLOCK B

Project No: NTC-C-201 Drawing No: A-221
DFA PROJECT NO. 95045

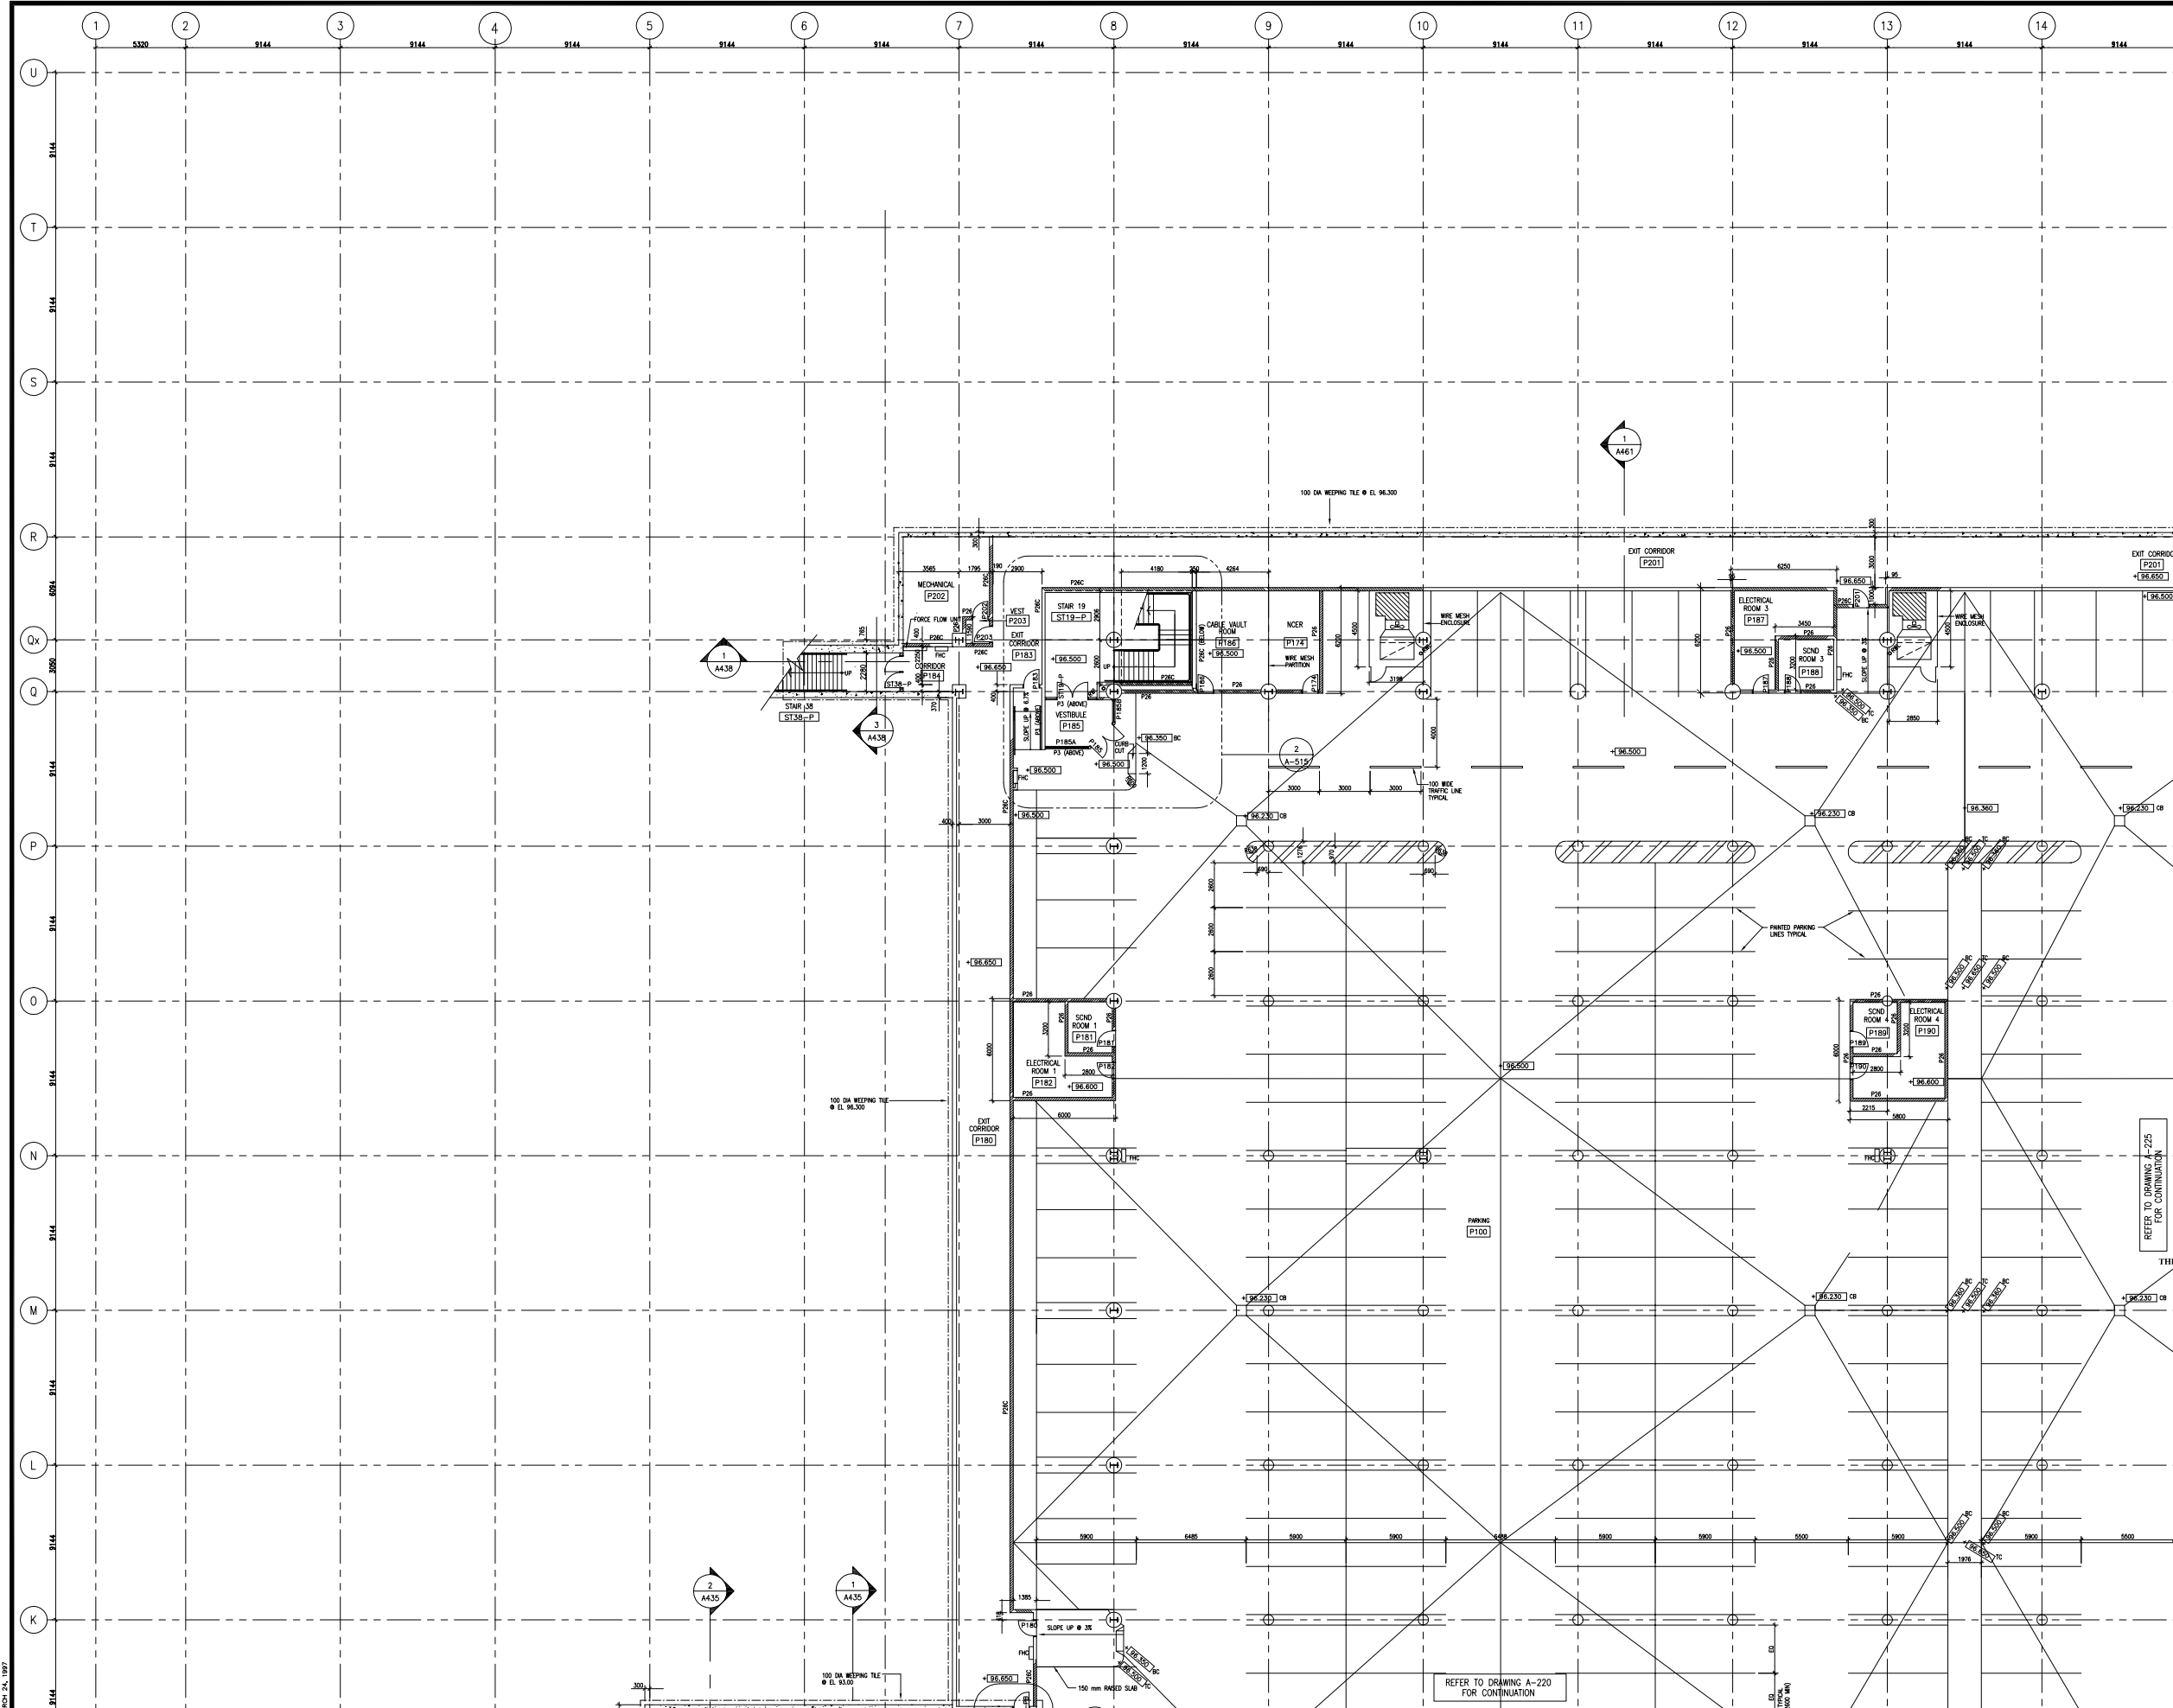

MARCH 24, 1997

The **PCL TEAM**

BLOCK E

NOTES

REVISED TO INCORPORATE FIELD INSTRUCTIONS, CHANGE ORDERS AND AS-BUILT INFORMATION SUPPLIED BY THE CONTRACTOR

CERTIFIED AS BUILT
PCL DESIGN CONSTRUCTORS INC.
Richardson
February 28, 1997

13	RECORD DRAWING	97-2-28
12	REVISED TO INCORPORATE UP TO FIA 320	97-1-10
11	REVISED TO INCORPORATE UP TO FIA 296	96-12-10
10	REVISED TO INCORPORATE FIA 01 TO 161 & CRX 01 TO 135	96-7-12
9	ISSUED FOR CONSTRUCTION	96-4-4
8	ISSUED FOR BUILDING PERMIT	96-2-26
7	ISSUED FOR PROGRESS REVIEW	96-1-10
6	ISSUED FOR PROGRESS REVIEW	95-12-10
5	ISSUED FOR PROGRESS REVIEW	95-11-10
4	ISSUED FOR PROGRESS REVIEW	95-10-17
3	ISSUED FOR REVIEW BY PCL	95-9-01
2	ISSUED FOR PROGRESS REVIEW	95-8-01
1	ISSUED FOR PROGRESS REVIEW	95-7-01

No. Revisions Date By

CONTRACTOR MUST CHECK AND VERIFY ALL DIMENSIONS ON THE JOB. DRAWING MUST NOT BE SCALE.

REFER TO DRAWING A-225 FOR CONTINUATION

REFER TO DRAWING A-220 FOR CONTINUATION

THE BOARD OF GOVERNORS OF EXHIBITION PLACE
EXHIBITION PLACE TORONTO
MARK U.C.

Zeidler Roberts Partnership
DUNLOP FARROW
ARCHITECTS IN JOINT VENTURE

NATIONAL TRADE CENTRE
AT
EXHIBITION PLACE

Drawn
Checked
Date
Title

Scale
1:125
Date
96-2-26


P1 LEVEL PLAN
BLOCK E

Project No.
NTC-C-201

Drawing No.
A-224

DFA PROJECT NO. 95045

EXHIBITION PLACE

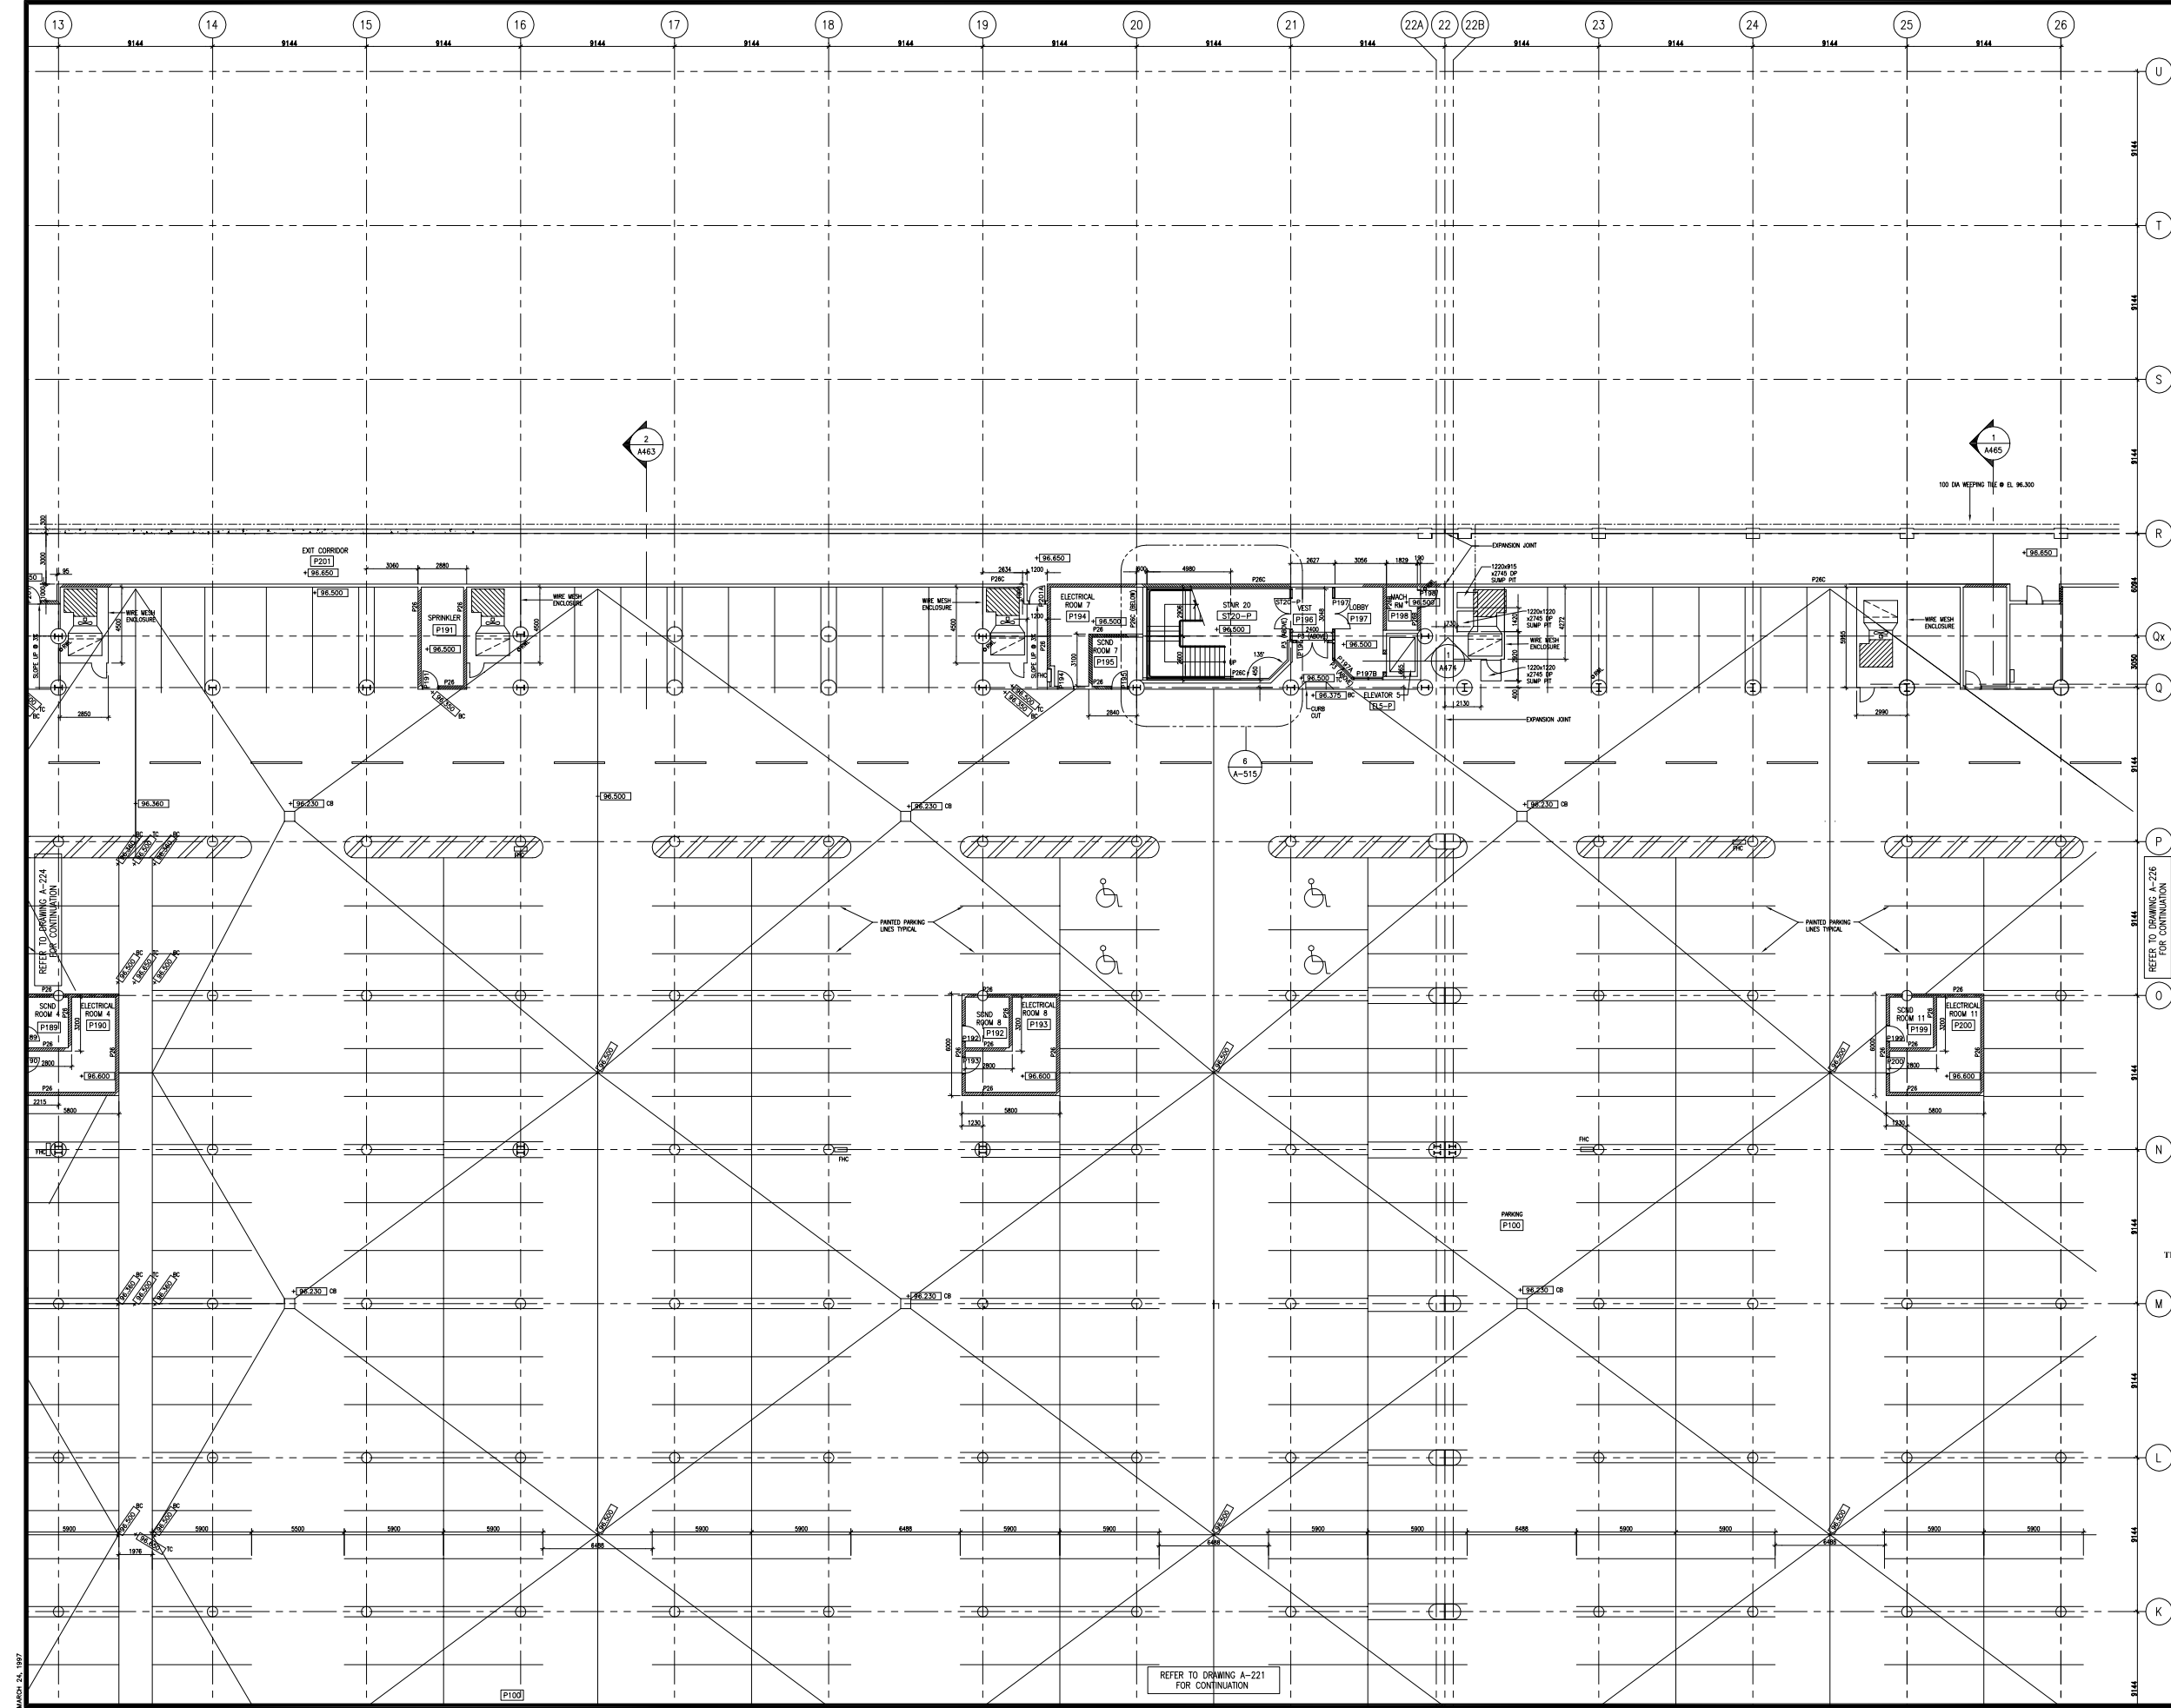

The **PCL TEAM**

BLOCK F

NOTES

REVISED TO INCORPORATE FIELD INSTRUCTIONS, CHANGE ORDERS AND AS-BUILT INFORMATION SUPPLIED BY THE CONTRACTOR

CERTIFIED AS BUILT
PCL DESIGN CONSTRUCTORS INC.
February 28, 1997

13	RECORD DRAWING	97-2-28
12	REVISED TO INCORPORATE UP TO FIA 320	97-1-10
11	REVISED TO INCORPORATE UP TO FIA 298	96-12-10
10	REVISED TO INCORPORATE FIA 01 TO 161 & CRX 01 TO 135	96-7-12
9	ISSUED FOR CONSTRUCTION	96-4-4
8	ISSUED FOR BUILDING PERMIT	96-2-28
7	ISSUED FOR PROGRESS REVIEW	96-1-10
6	ISSUED FOR PROGRESS REVIEW	95-12-10
5	ISSUED FOR PROGRESS REVIEW	95-11-10
4	ISSUED FOR PROGRESS REVIEW	95-10-27
3	ISSUED FOR REVIEW BY PCL	95-9-01
2	ISSUED FOR PROGRESS REVIEW	95-9-01
1	ISSUED FOR PROGRESS REVIEW	95-9-01

No. Revisions Date By

CONTRACTOR MUST CHECK AND VERIFY ALL DIMENSIONS ON THE JOB. DRAWING MUST BE IN SCALE.

THE BOARD OF GOVERNORS OF EXHIBITION PLACE
EXHIBITION PLACE TORONTO
MARK 3C3


Zeidler Roberts Partnership
DEVELOP
ARCHITECTS IN JOINT VENTURE

NATIONAL TRADE CENTRE
AT
EXHIBITION PLACE

Drawn
Checked
Date
Title
Project No.
Drawing No.

Scale
1:125
96-2-26
P1 LEVEL PLAN
BLOCK F
NTC-C-201
A-225
DFA PROJECT NO. 95045

EXHIBITION PLACE

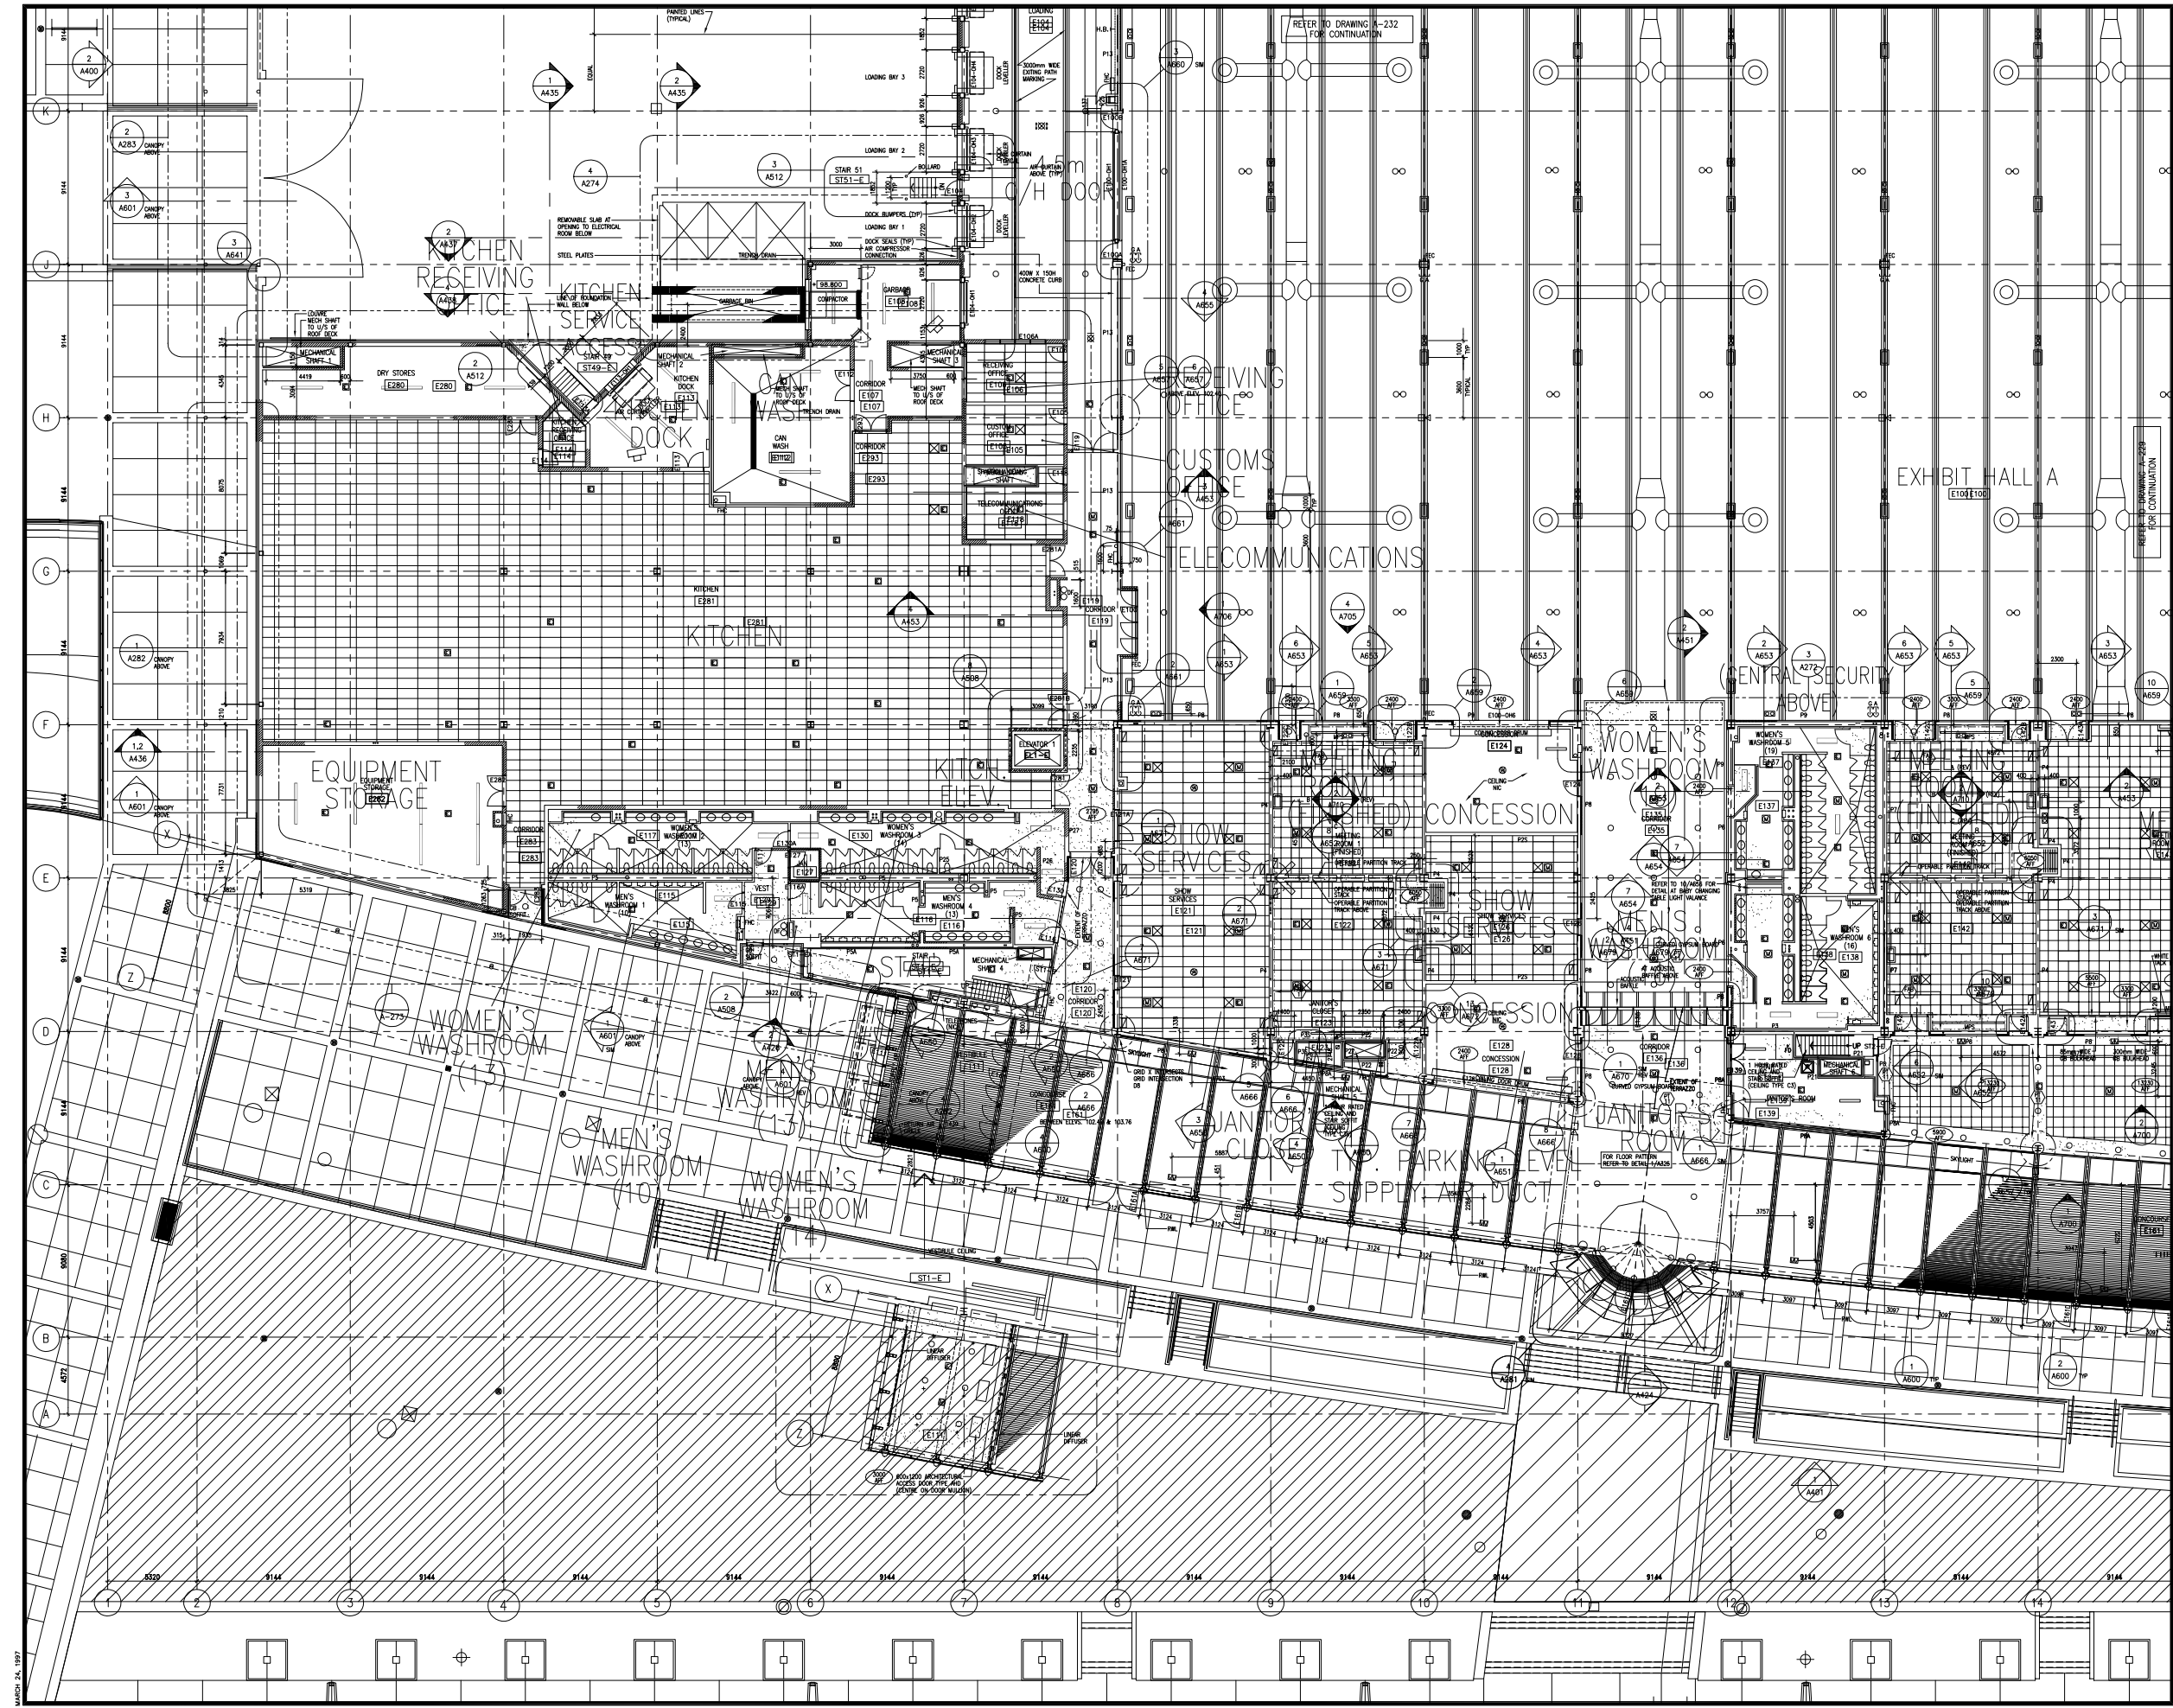

The **PCL TEAM**

Block A

NOTES

REVISED TO INCORPORATE FIELD INSTRUCTIONS, CHANGE ORDERS AND AS-BUILT INFORMATION SUPPLIED BY THE CONTRACTOR

CERTIFIED AS BUILT
PCL DESIGN CONSTRUCTORS INC.
[Signature]
February 28, 1997

13	RECORD DRAWING	97-2-28
12	REVISED TO INCORPORATE UP TO FIA 320	97-1-10
11	REVISED TO INCORPORATE UP TO FIA 298	96-12-10
10	REVISED TO INCORPORATE FIA 91 TO 98 & DRY 01 TO 135	96-7-12
9	ISSUED FOR CONSTRUCTION	96-4-4
8	ISSUED FOR BUILDING PERMIT	96-2-26
7	ISSUED FOR PROGRESS REVIEW	96-1-1
6	ISSUED FOR PROGRESS REVIEW	95-12-1
5	ISSUED FOR PROGRESS REVIEW	95-11-1
4	ISSUED FOR PROGRESS REVIEW	95-11-1
3	ISSUED FOR REVIEW BY PCL	95-10-27
2	ISSUED FOR PROGRESS REVIEW	95-9-01
1	ISSUED FOR PROGRESS REVIEW	95-9-01

CONTRACTOR SHALL VERIFY ALL DIMENSIONS ON THE JOB. REVISIONS MUST BE SUBMITTED.

THE BOARD OF GOVERNORS OF EXHIBITION PLACE
EXHIBITION PLACE, TORONTO
M6K 3C3

Zeidler Roberts Partnership

BUILD UP
FARROW
ARCHITECTS IN JOINT VENTURE

NATIONAL TRADE CENTRE
AT
EXHIBITION PLACE



Drawn
Checked
Title
EXHIBITION LEVEL PLAN
BLOCK A

Scale
1:125
Date
96-2-26

Project No.
NTC-C-201

Drawing No.
A-228
DFA PROJECT NO. 95045

EXHIBITION PLACE

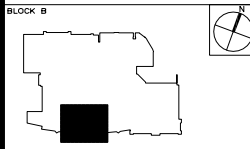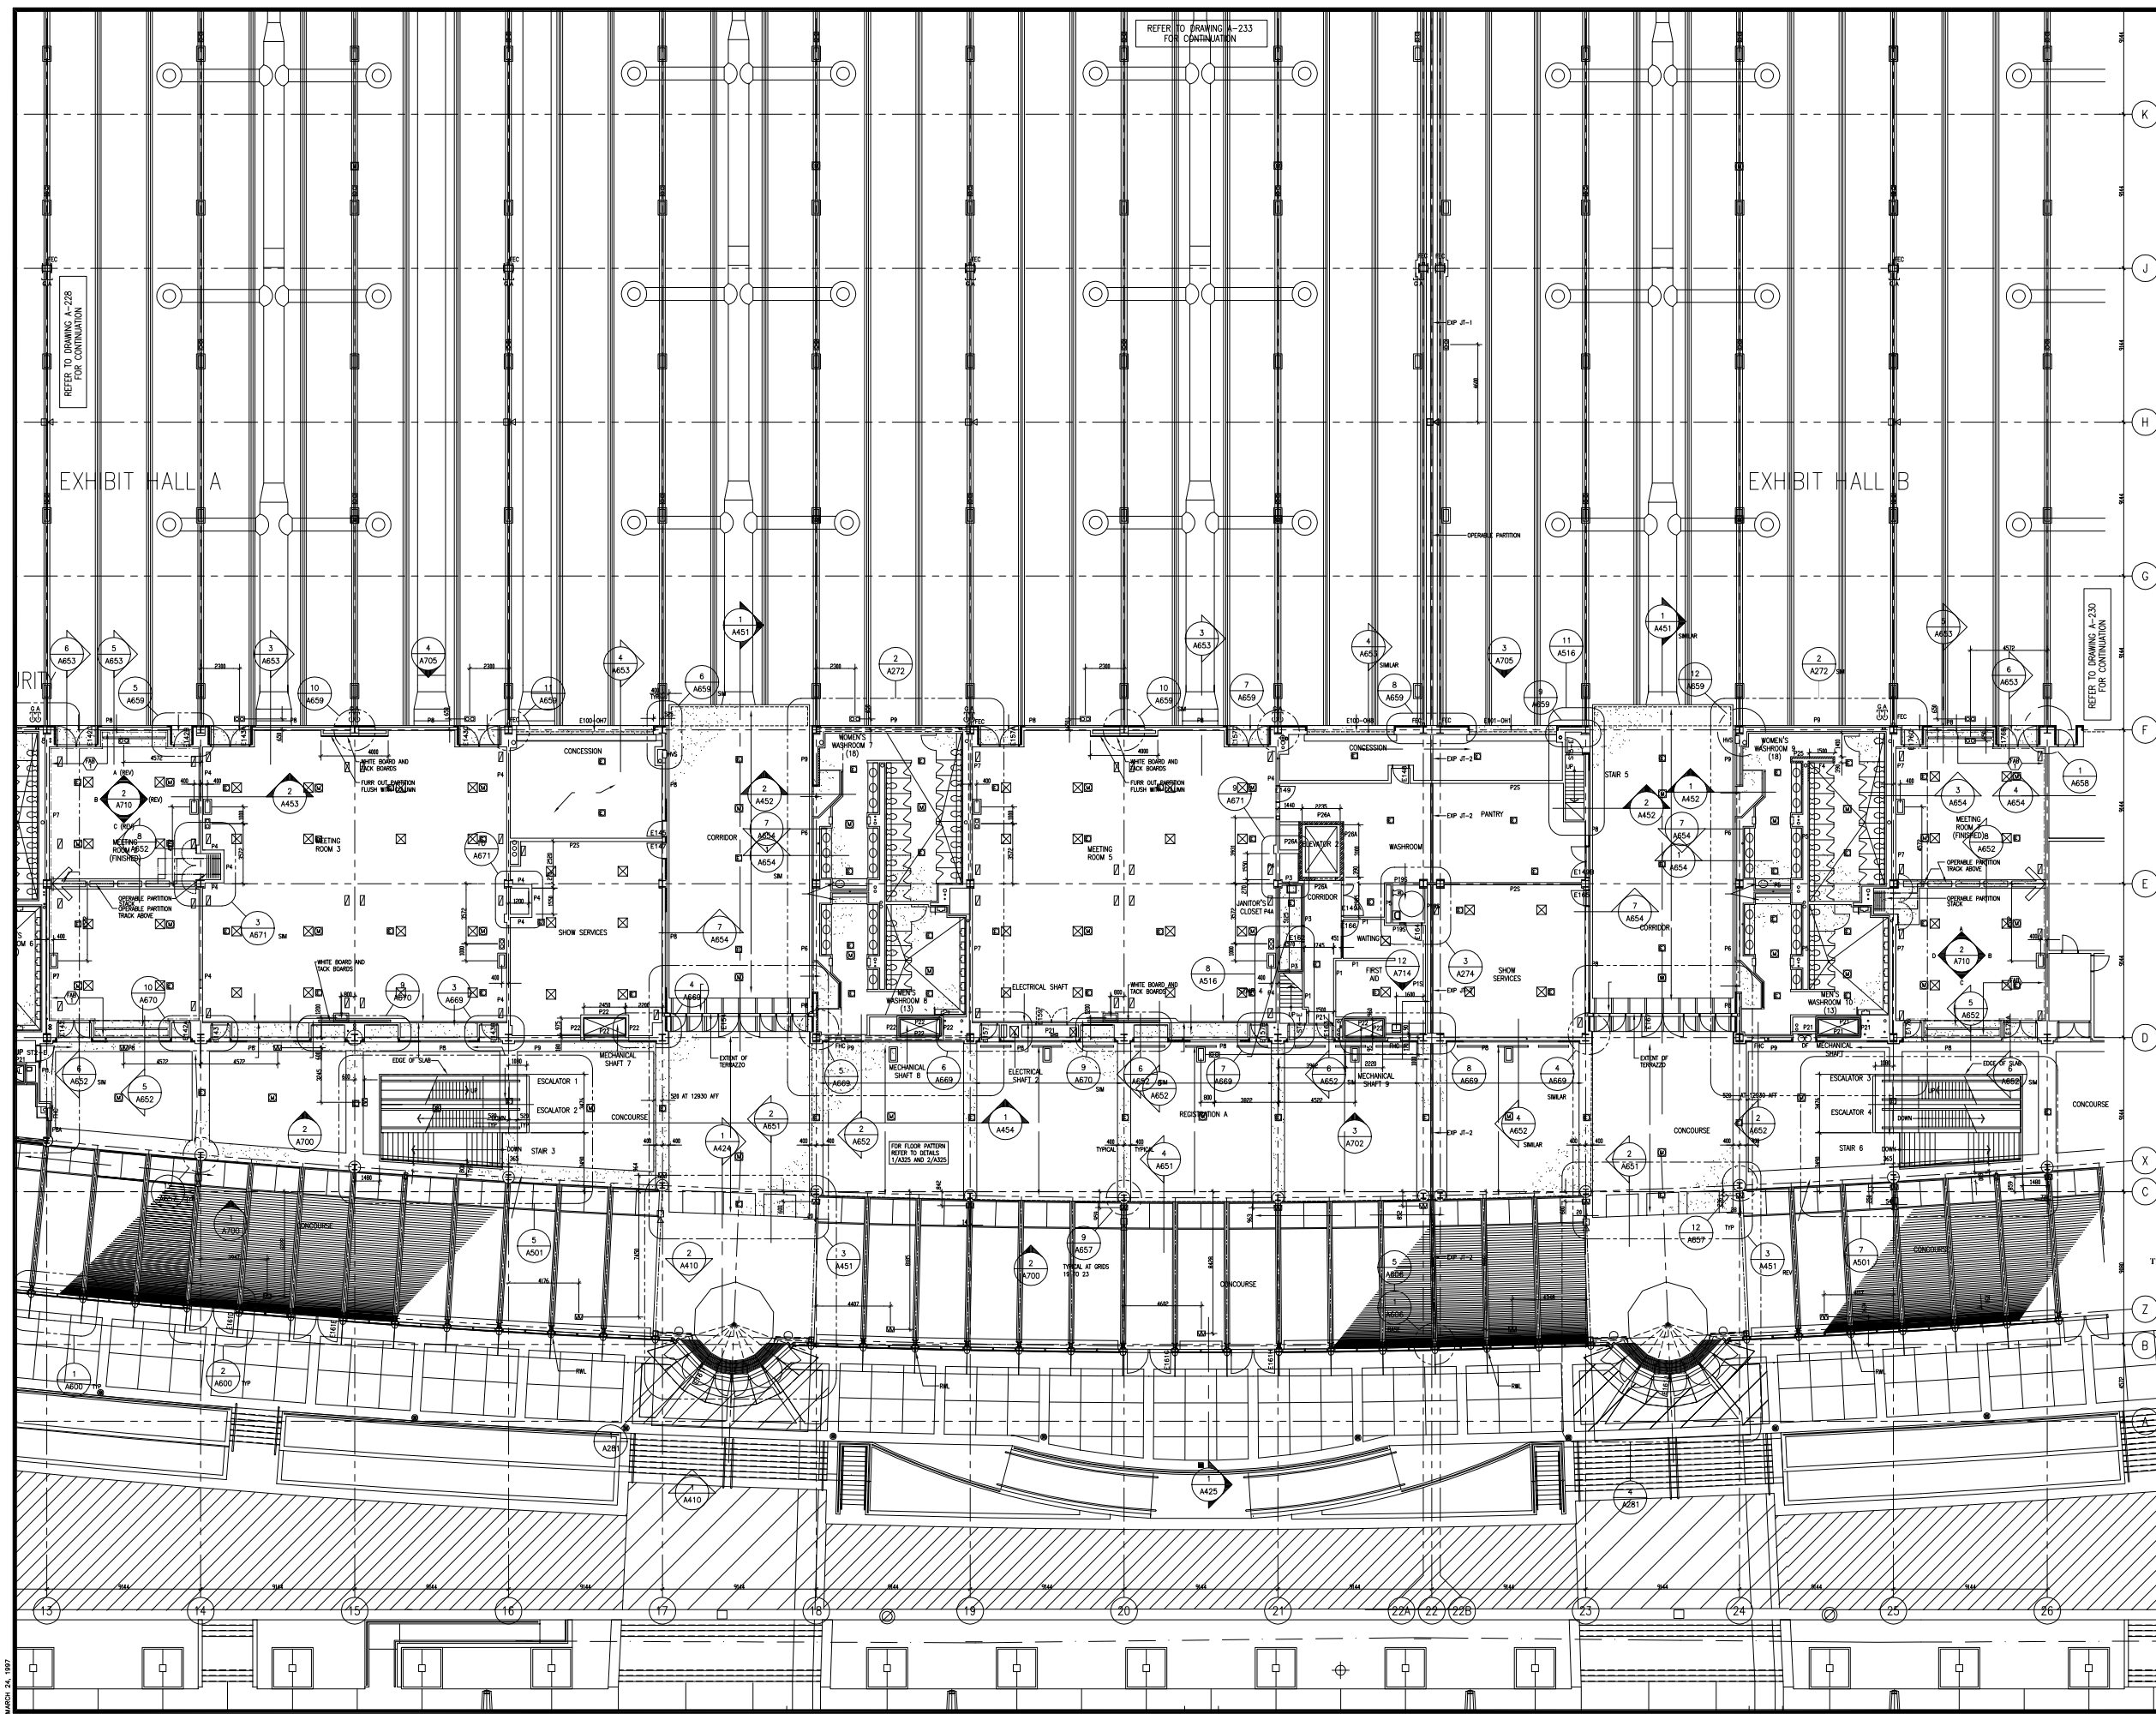

NOTES

REVISED TO INCORPORATE FIELD INSTRUCTIONS, CHANGE ORDERS AND AS-BUILT INFORMATION SUPPLIED BY THE CONTRACTOR

CERTIFIED AS BUILT
PCL DESIGN CONSTRUCTORS INC.
Richard Green
February 28, 1997

13	RECORD DRAWING	97-2-28
12	REVISED TO INCORPORATE UP TO FIA 320	97-1-10
11	REVISED TO INCORPORATE UP TO FIA 298	96-12-10
10	REVISED TO INCORPORATE FIA 01 TO 161 & 02X 01 TO 135	96-7-12
9	ISSUED FOR CONSTRUCTION	96-4-4
8	ISSUED FOR BUILDING PERMIT	96-2-26
7	ISSUED FOR PROGRESS REVIEW	96-1-10
6	ISSUED FOR PROGRESS REVIEW	95-12-12
5	ISSUED FOR PROGRESS REVIEW	95-11-11
4	ISSUED FOR PROGRESS REVIEW	95-11-11
3	ISSUED FOR REVIEW BY PCL	95-10-27
2	ISSUED FOR PROGRESS REVIEW	95-9-01
1	ISSUED FOR PROGRESS REVIEW	95-9-01
No.	Revisions	Date By

REVISIONS MUST BE MADE AND VERIFY ALL DIMENSIONS ON THE JOB. DRAWING MUST BE SEAL.



Zeidler Roberts Partnership

DUNLOP FARRROW

ARCHITECTS IN JOINT VENTURE

NATIONAL TRADE CENTRE AT EXHIBITION PLACE

Drawn: 1:125
Checked: 96-2-26
Date: 96-2-26

EXHIBITION LEVEL PLAN
BLOCK B

Project No. NTC-C-201
Drawing No. A-229
DFA PROJECT NO. 95045

EXHIBITION PLACE

NOTES

REVISED TO INCORPORATE FIELD INSTRUCTIONS, CHANGE ORDERS AND AS-BUILT INFORMATION SUPPLIED BY THE CONTRACTOR

CERTIFIED AS BUILT
PCL DESIGN CONSTRUCTORS INC.
Richard Orsini
February 28, 1997

13	RECORD DRAWING	97-2-28
12	REVISED TO INCORPORATE UP TO FIA 320	97-1-10
11	REVISED TO INCORPORATE UP TO FIA 298	96-12-10
10	REVISED TO INCORPORATE FIA 01 TO 161 & CRX 01 TO 135	96-7-12
9	ISSUED FOR CONSTRUCTION	96-4-4
8	ISSUED FOR BUILDING PERMIT	96-2-26
7	ISSUED FOR PROGRESS REVIEW	96-1-1
6	ISSUED FOR PROGRESS REVIEW	95-12-1
5	ISSUED FOR PROGRESS REVIEW	95-11-1
4	ISSUED FOR PROGRESS REVIEW	95-11-1
3	ISSUED FOR REVIEW BY PCL	95-10-27
2	ISSUED FOR PROGRESS REVIEW	95-9-1
1	ISSUED FOR PROGRESS REVIEW	95-9-01
No.	Revisions	Date By


CONTRACTOR SHALL VERIFY ALL DIMENSIONS ON THE JOB. DRAWING MAY NOT BE SCALED.

BOARD OF GOVERNORS OF EXHIBITION PLACE
EXHIBITION PLACE TORONTO
MARK 3C3


Zeidler Roberts Partnership
BULLOP FARROW
ARCHITECTS IN JOINT VENTURE
NATIONAL TRADE CENTRE
AT
EXHIBITION PLACE

Drawn: Scale: 1:125
Checked: Date: 96-2-26
Title: EXHIBITION LEVEL PLAN
BLOCK E
Project No: NTC-C-201
Drawing No: A-232
DFA PROJECT NO: 95045

EXHIBITION PLACE

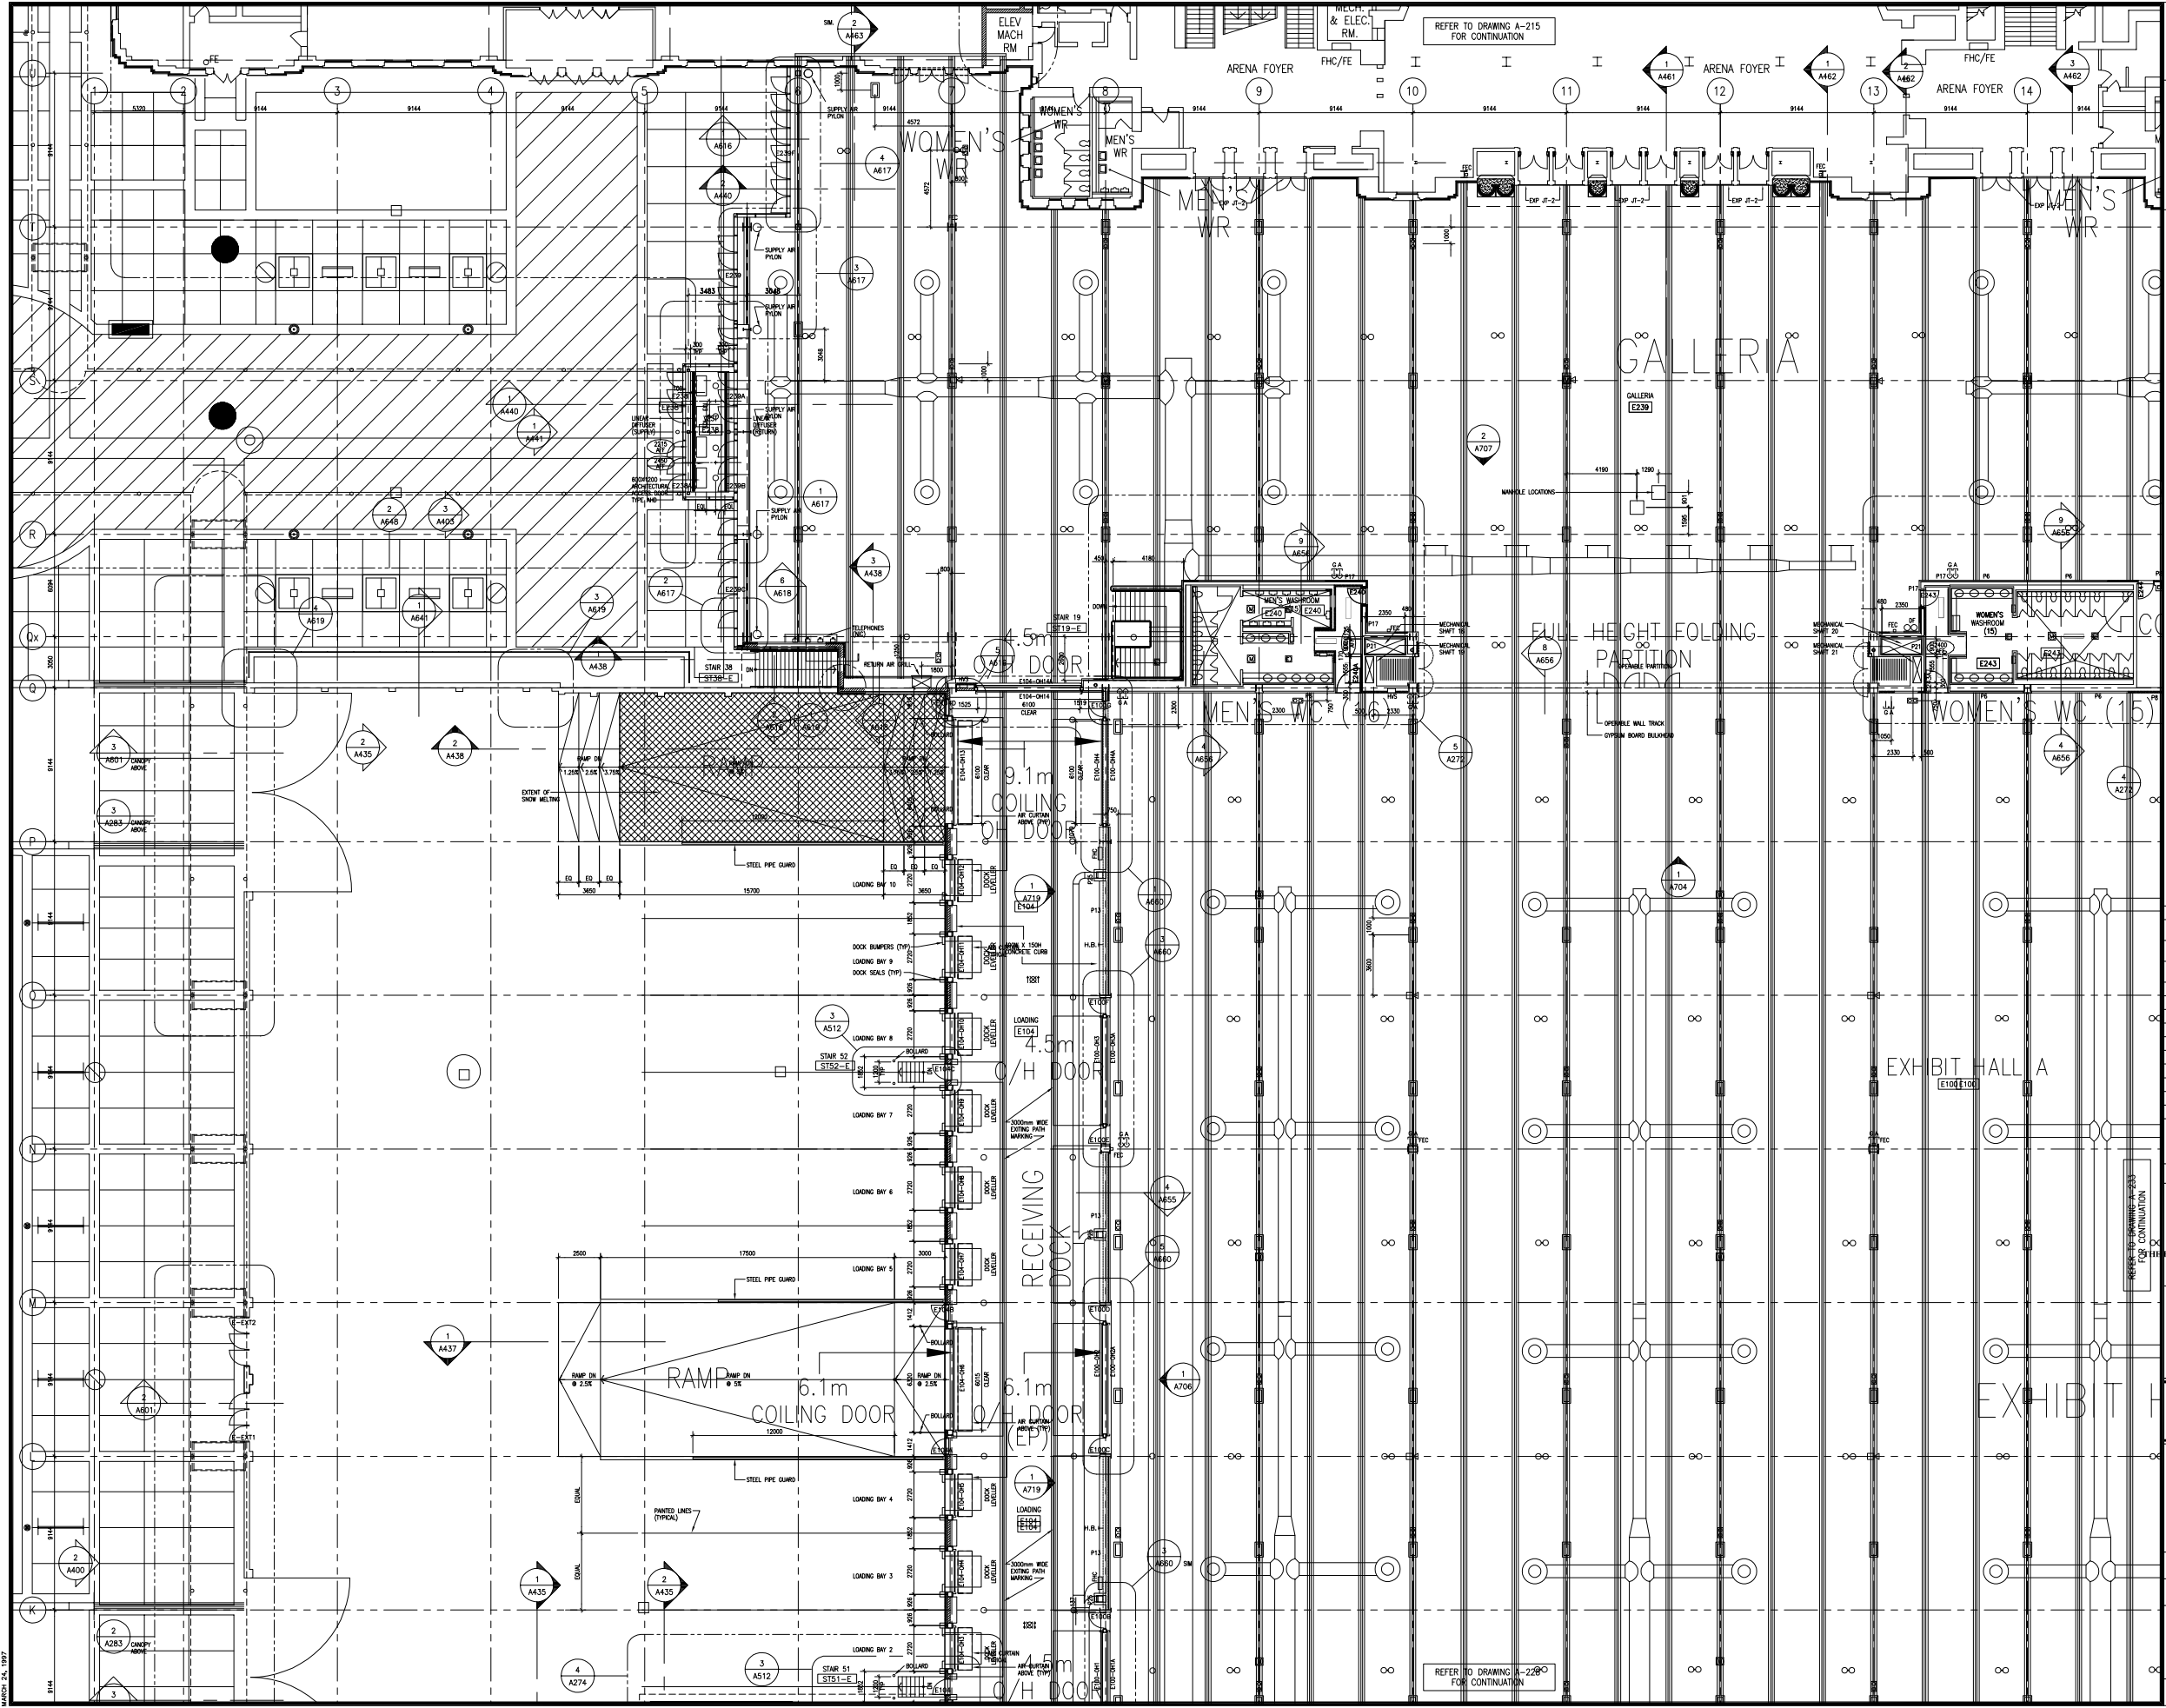

MARCH 24, 1997

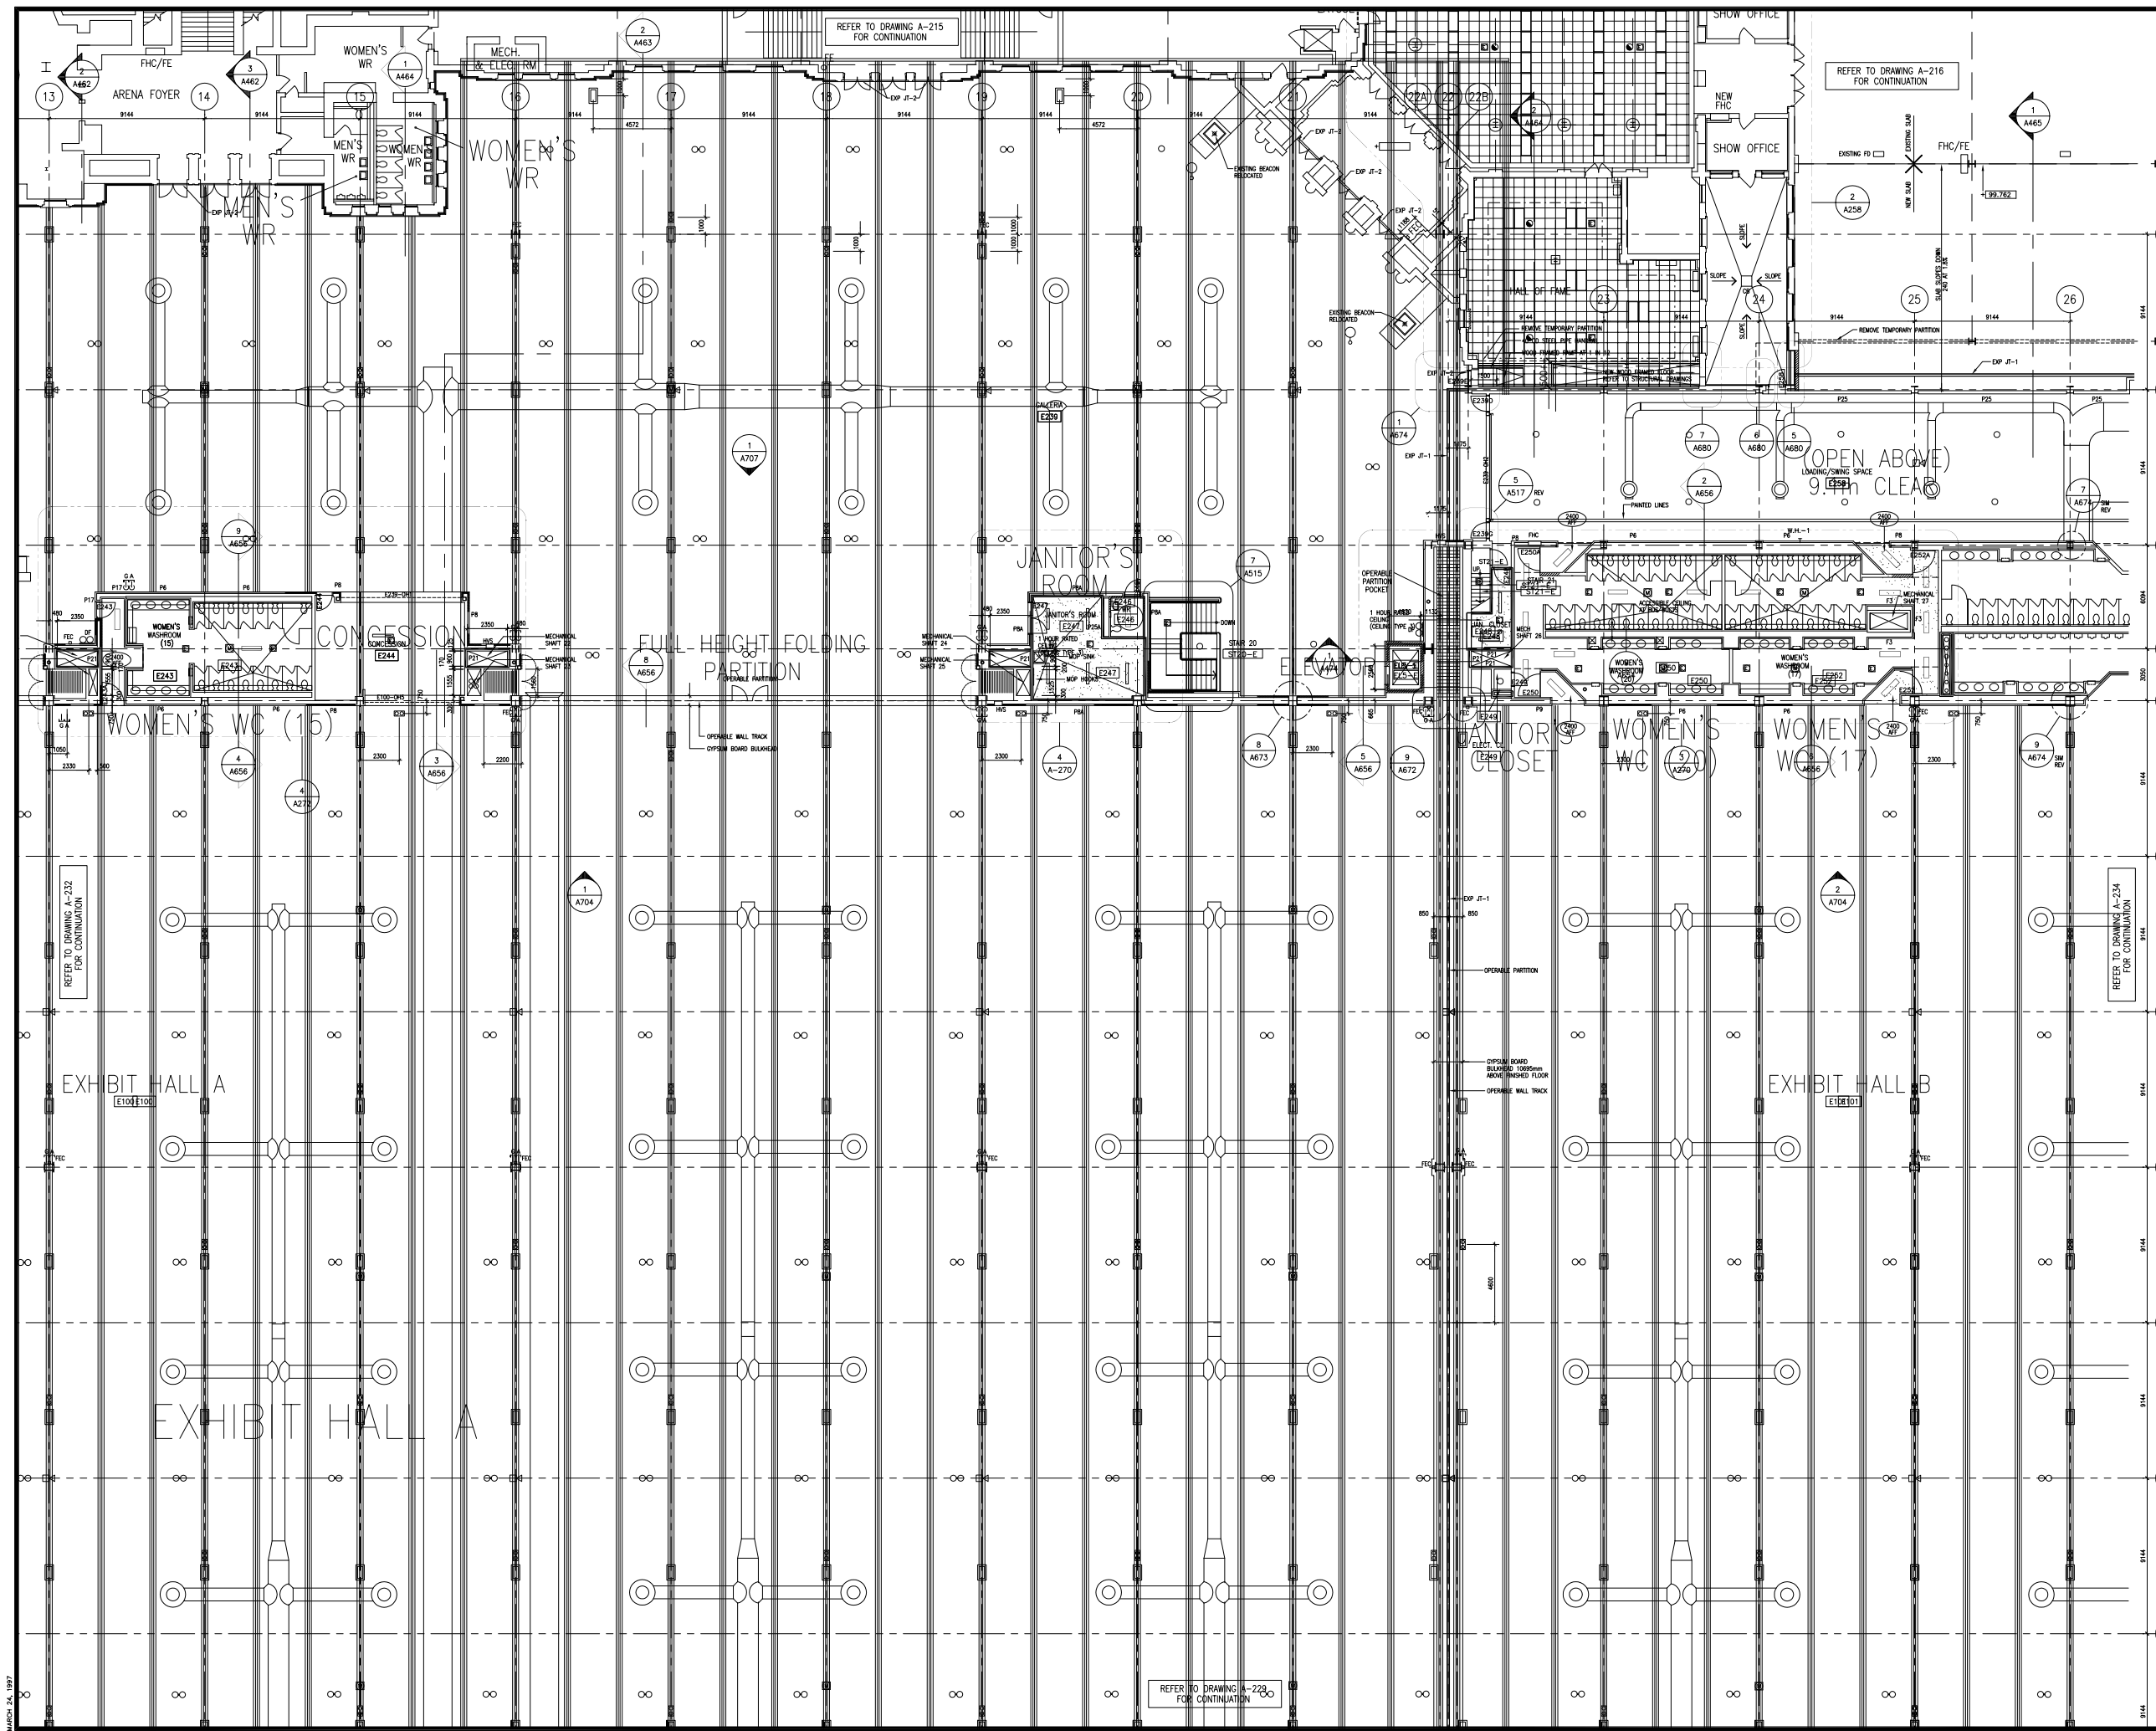

BLOCK F

NOTES

REVISED TO INCORPORATE FIELD INSTRUCTIONS, CHANGE ORDERS AND AS-BUILT INFORMATION SUPPLIED BY THE CONTRACTOR

CERTIFIED AS BUILT
PCL DESIGN CONSTRUCTORS INC.

February 28, 1997

13	RECORD DRAWING	97-2-28
12	REVISED TO INCORPORATE UP TO FIA 320	97-1-10
11	REVISED TO INCORPORATE UP TO FIA 298	96-12-10
10	REVISED TO INCORPORATE FIA 01 TO 181 & CRD 01 TO 135	96-7-12
9	ISSUED FOR CONSTRUCTION	96-4-4
8	ISSUED FOR BUILDING PERMIT	96-2-26
7	ISSUED FOR PROGRESS REVIEW	96-1-2
6	ISSUED FOR PROGRESS REVIEW	95-12-1
5	ISSUED FOR PROGRESS REVIEW	95-11-1
4	ISSUED FOR PROGRESS REVIEW	95-10-27
3	ISSUED FOR REVIEW BY PCL	95-10-27
2	ISSUED FOR PROGRESS REVIEW	95-9-01
1	ISSUED FOR PROGRESS REVIEW	95-8-01

No. Revisions Date By

Zeidler Roberts Partnership

ARCHITECTS IN JOINT VENTURE
NATIONAL TRADE CENTRE
AT
EXHIBITION PLACE

Drawn
—
Checked
—
Title
EXHIBITION LEVEL PLAN
BLOCK F

Scale
1:125
Date
96-2-26

Project No.
NTC-C-201
Drawing No.
A-233

EXHIBITION PLACE

MARCH 24, 1997